



Exhibit A-51: Semrau Engineering & Surveying, Grip Road
Gravel Mine Access Road as built drawings (Sept. 13, 2018)

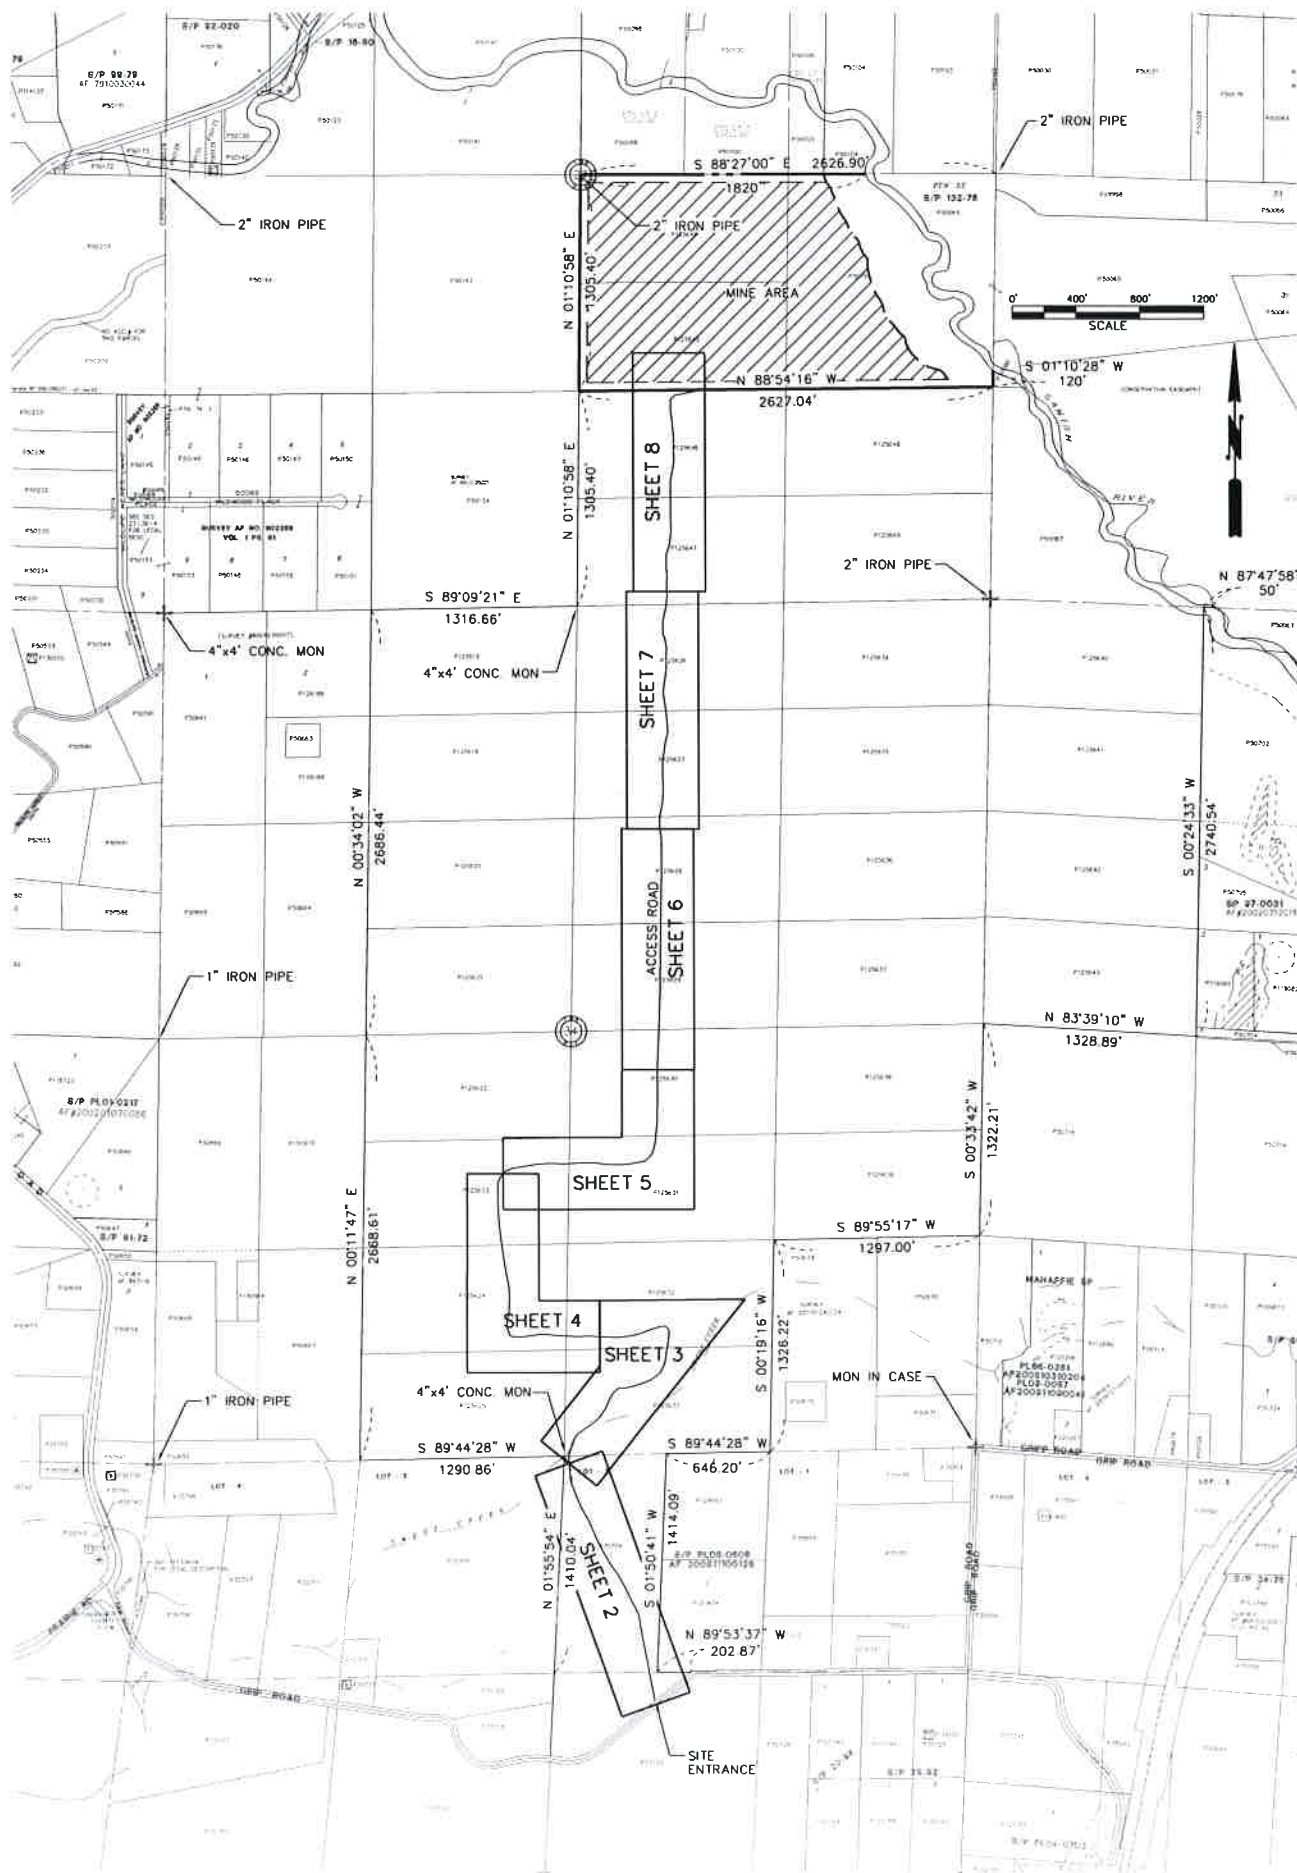


**GRIP ROAD GRAVEL MINE
ACCESS ROAD AS BUILT
SECTIONS 27 & 34, TOWNSHIP 36 NORTH, RANGE 4 EAST, W.M.
SECTION 3, TOWNSHIP 35 NORTH, RANGE 4 EAST, W.M.
SKAGIT COUNTY, WASHINGTON**

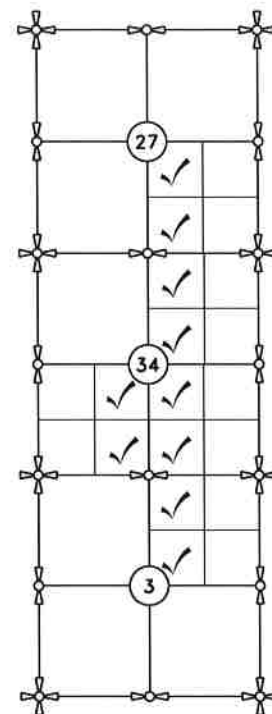

VICINITY MAP
N.T.S.

SURVEY NOTES:

1. MERIDIAN: ASSUMED, BASED ON RECORDED SURVEYS
2. DATUM: NAVD88, FROM RTK GPS
3. CONTOURS AND FEATURES FROM TOPOGRAPHIC SURVEY BY STANDARD FIELD TRAVERSE.
4. NO UTILITY RESEARCH OR LOCATE SERVICE USED. ONLY VISIBLE UTILITIES SHOWN.
5. THE PURPOSE OF THIS SURVEY WAS FOR AS CONSTRUCTED ROADWAY RECORDS, AS REQUESTED BY MILES SAND AND GRAVEL
6. INSTRUMENTATION USED ON THIS SURVEY:
LEICA MS50 THEODOLITE DISTANCE METER
LEICA VIVA 14 GPS/GNSS RECEIVERS
7. EXCEPT AS SPECIFICALLY STATED OR SHOWN ON THIS SURVEY MAP, THIS SURVEY DOES NOT PURPORT TO REFLECT ALL OF THE FOLLOWING WHICH MAY BE APPLICABLE TO THE SUBJECT REAL ESTATE: EASEMENTS, BUILDING SETBACKS LINES, RESTRICTIVE COVENANTS, SUBDIVISION RESTRICTIONS, ZONING OR OTHER LAND-USE REGULATIONS AND ANY OTHER FACTS THAT AN ACCURATE AND CURRENT TITLE SEARCH MAY DISCLOSE.

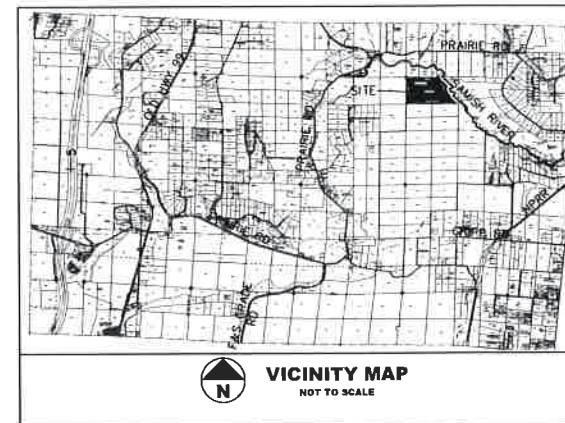

APPLICANT/OWNER
MILES SAND AND GRAVEL
663 PEASE ROAD
BURLINGTON, WA 98233
CONTACT: DAN COX
TEL: (360) 757-3121

CIVIL ENGINEER/SURVEYOR
SEMRAU ENGINEERING AND SURVEYING
2118 RIVERSIDE DRIVE SUITE 208
MOUNT VERNON, WA 98273
CONTACT: JOHN B. SEMRAU P.E. & P.L.S.
TEL: (360) 424-9566

TABLE OF CONTENTS



SHEET NO.	DRAWING TITLE
1	CONTENTS AND VICINITY MAP
2	STATION 0+00 TO STATION 15+00
3	STATION 15+00 TO STATION 30+00
4	STATION 30+00 TO STATION 45+00
5	STATION 45+00 TO STATION 60+00
6	STATION 60+00 TO STATION 75+00
7	STATION 75+00 TO STATION 90+00
8	STATION 90+00 TO STATION 105+00
9	CROSS-SECTIONS
10	SIGNAGE PLAN STATION 15+00 TO 30+00








SHEET 1 OF 10

**CONTENTS AND VICINITY MAP
GRIP ROAD GRAVEL MINE ACCESS ROAD AS BUILT
SECTIONS 27 & 34, T. 36 N., R. 4 E., W.M.
SECTION 3, T. 35 N., R. 4 E., W.M.
SKAGIT COUNTY, WASHINGTON**

DATUM:	NAVD 88	SEMRAU ENGINEERING & SURVEYING	SCALE: 1" = 600'
MERIDIAN:	ASSUMED	SURVEYING • ENGINEERING • PLANNING MOUNT VERNON, WA 98273 360-424-9566	JOB NO. 5166

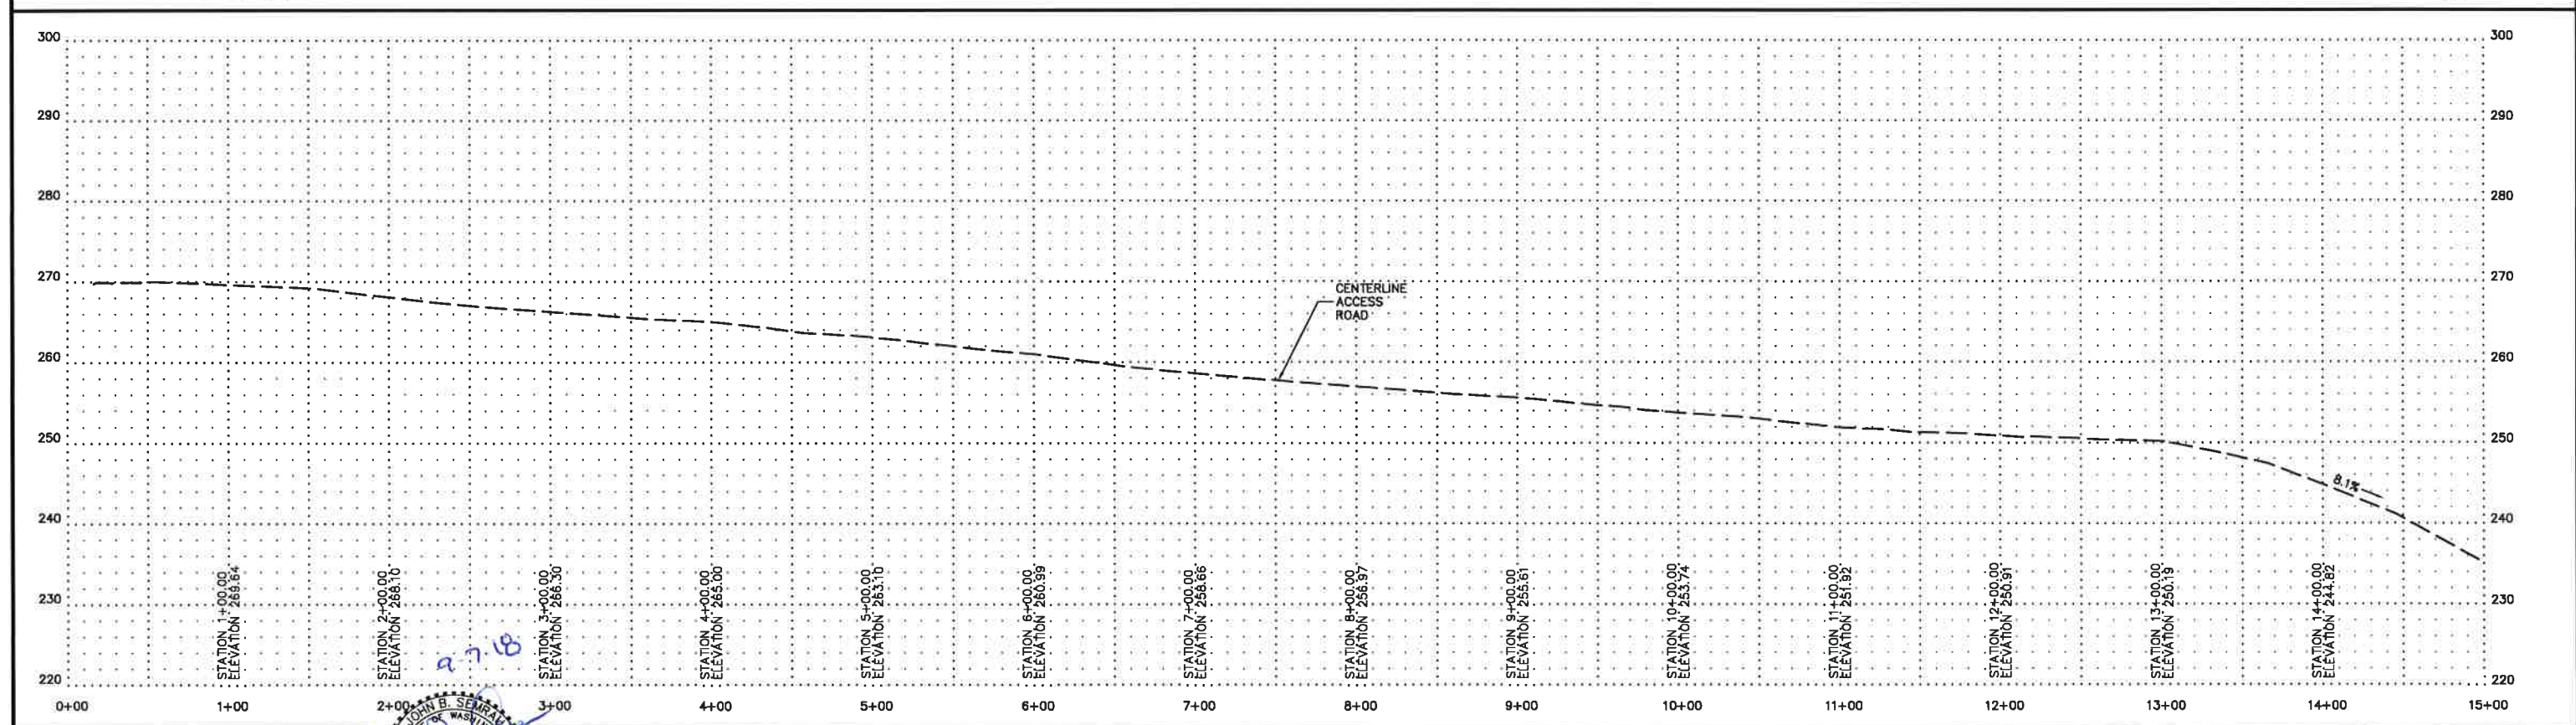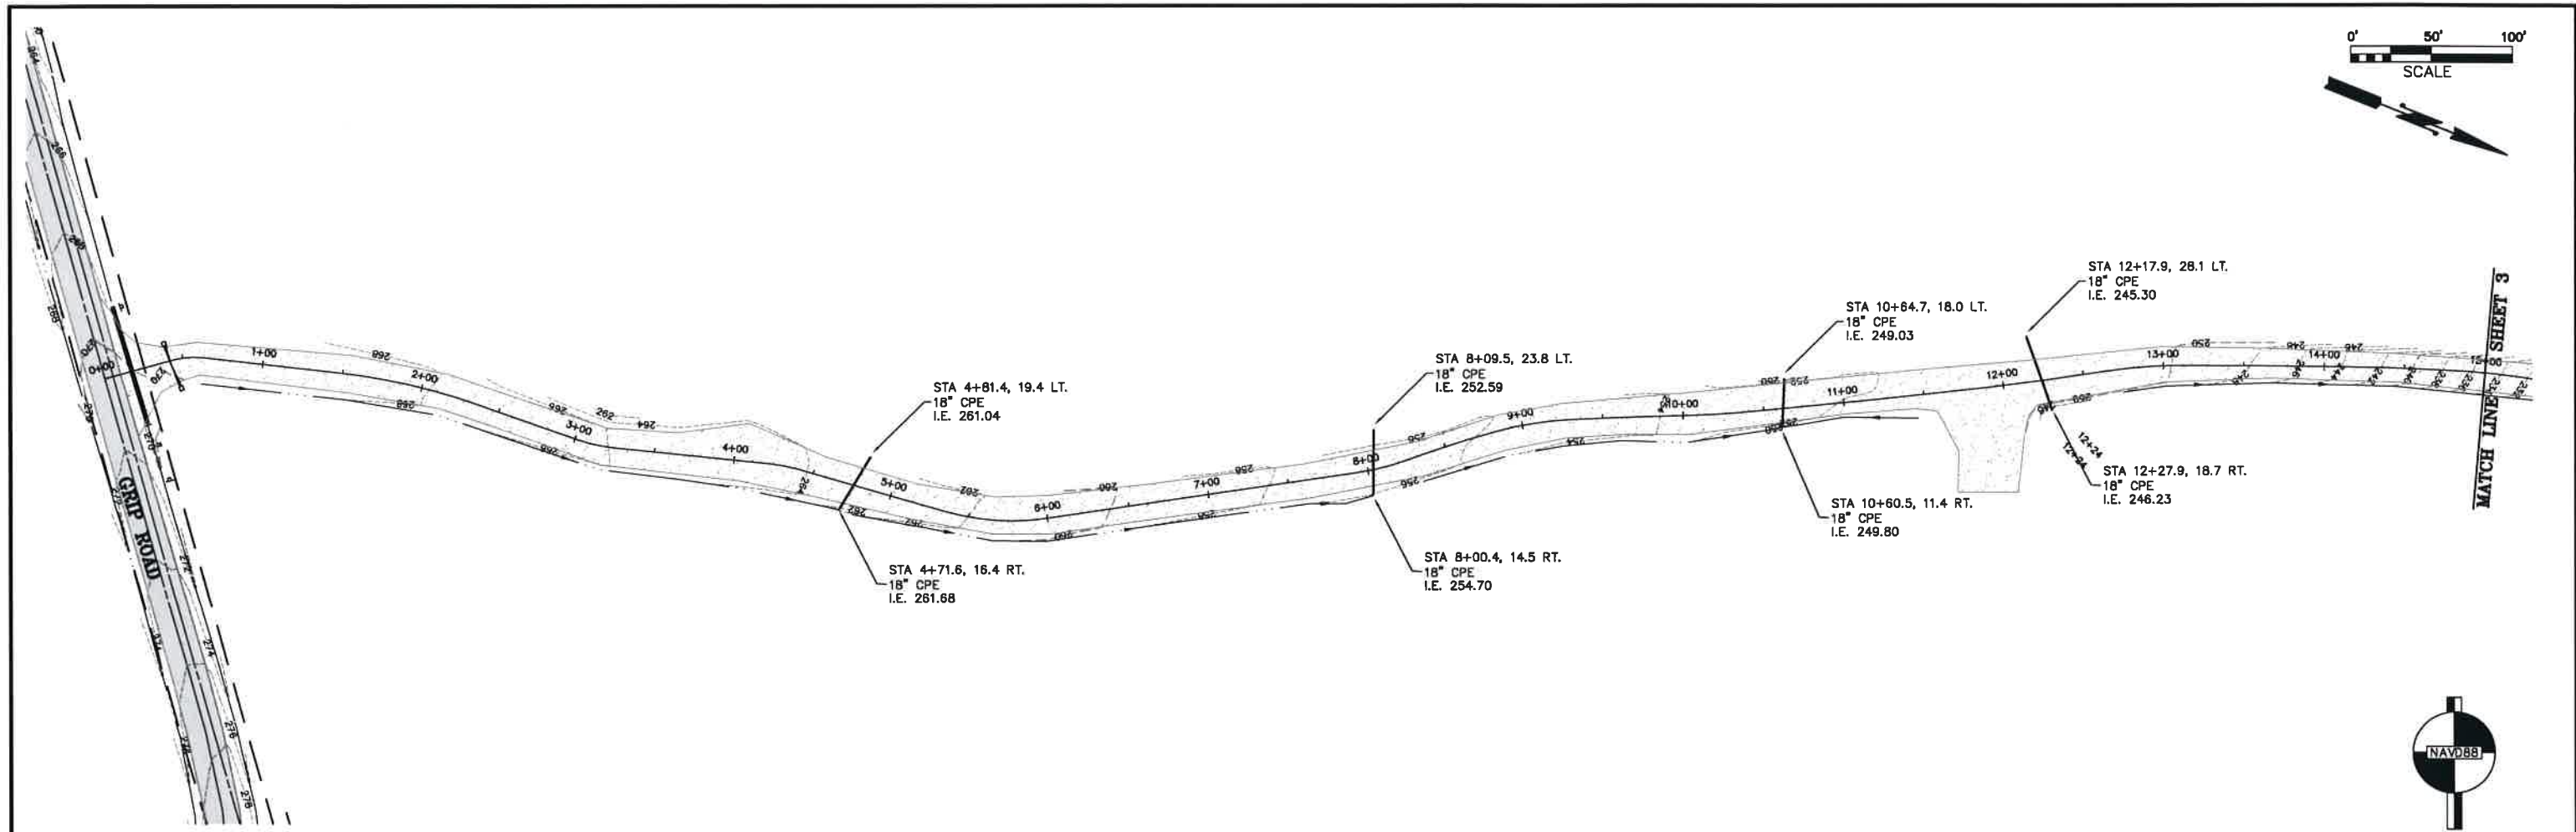

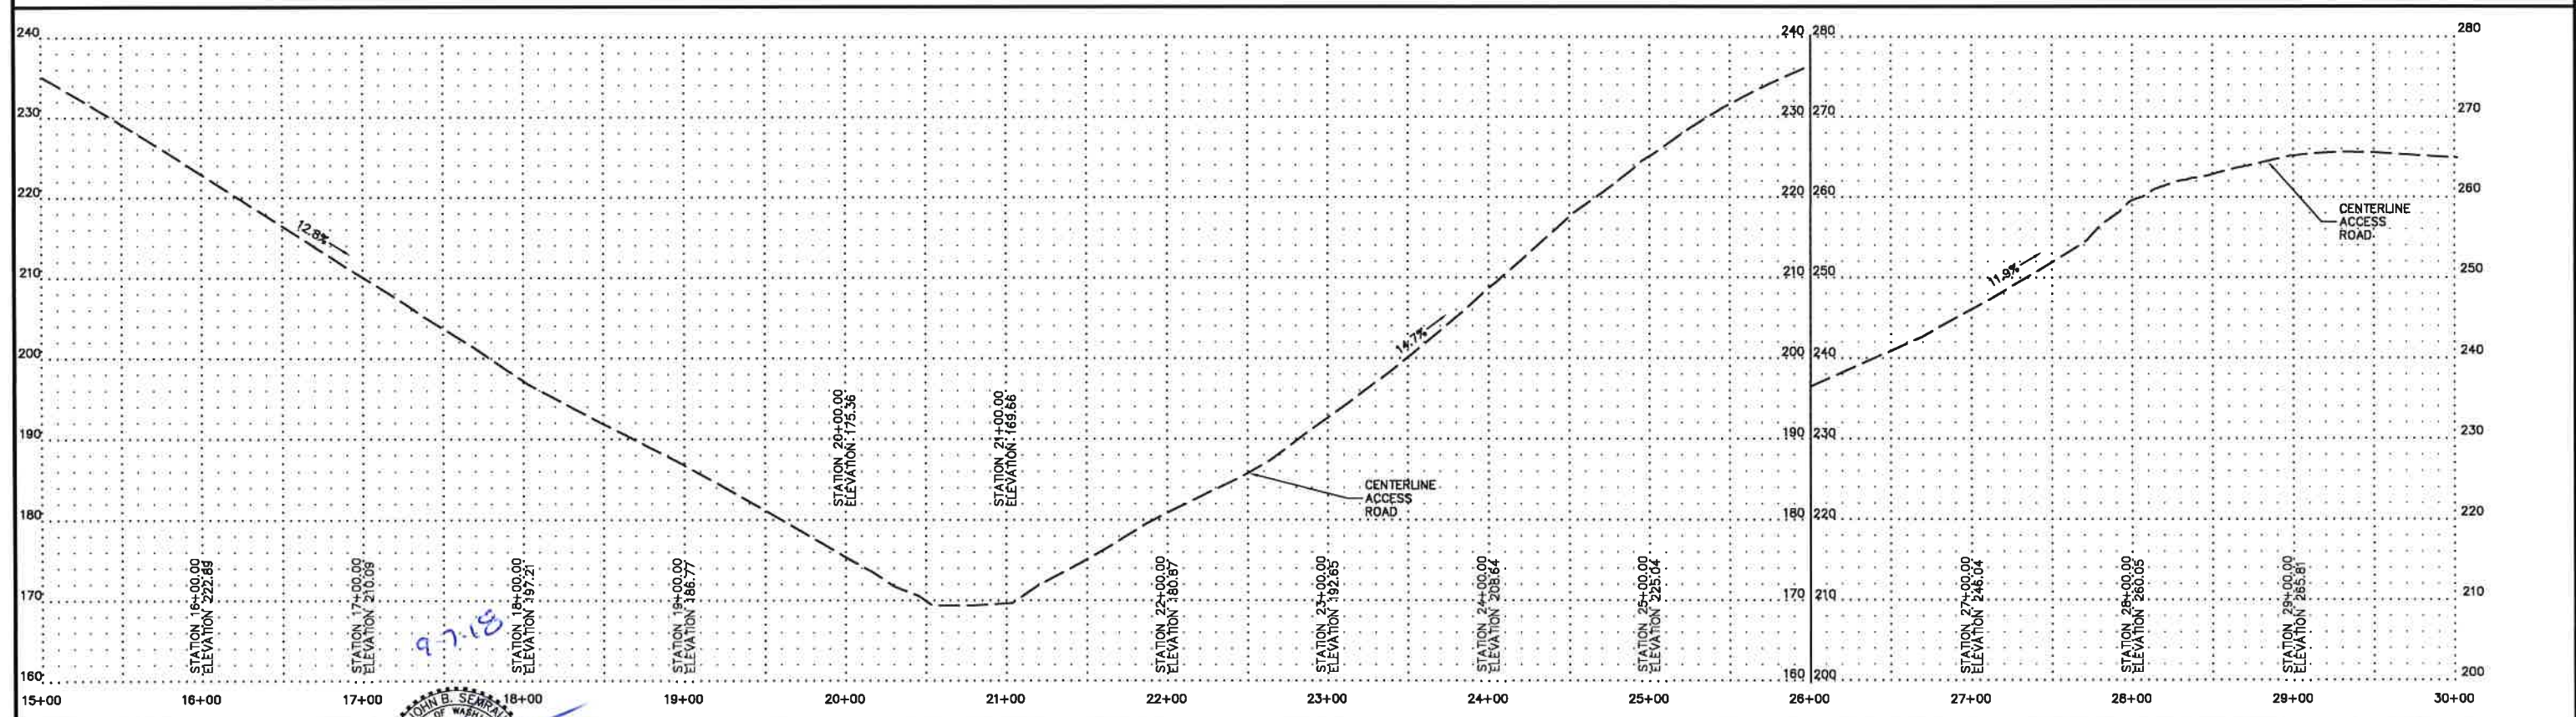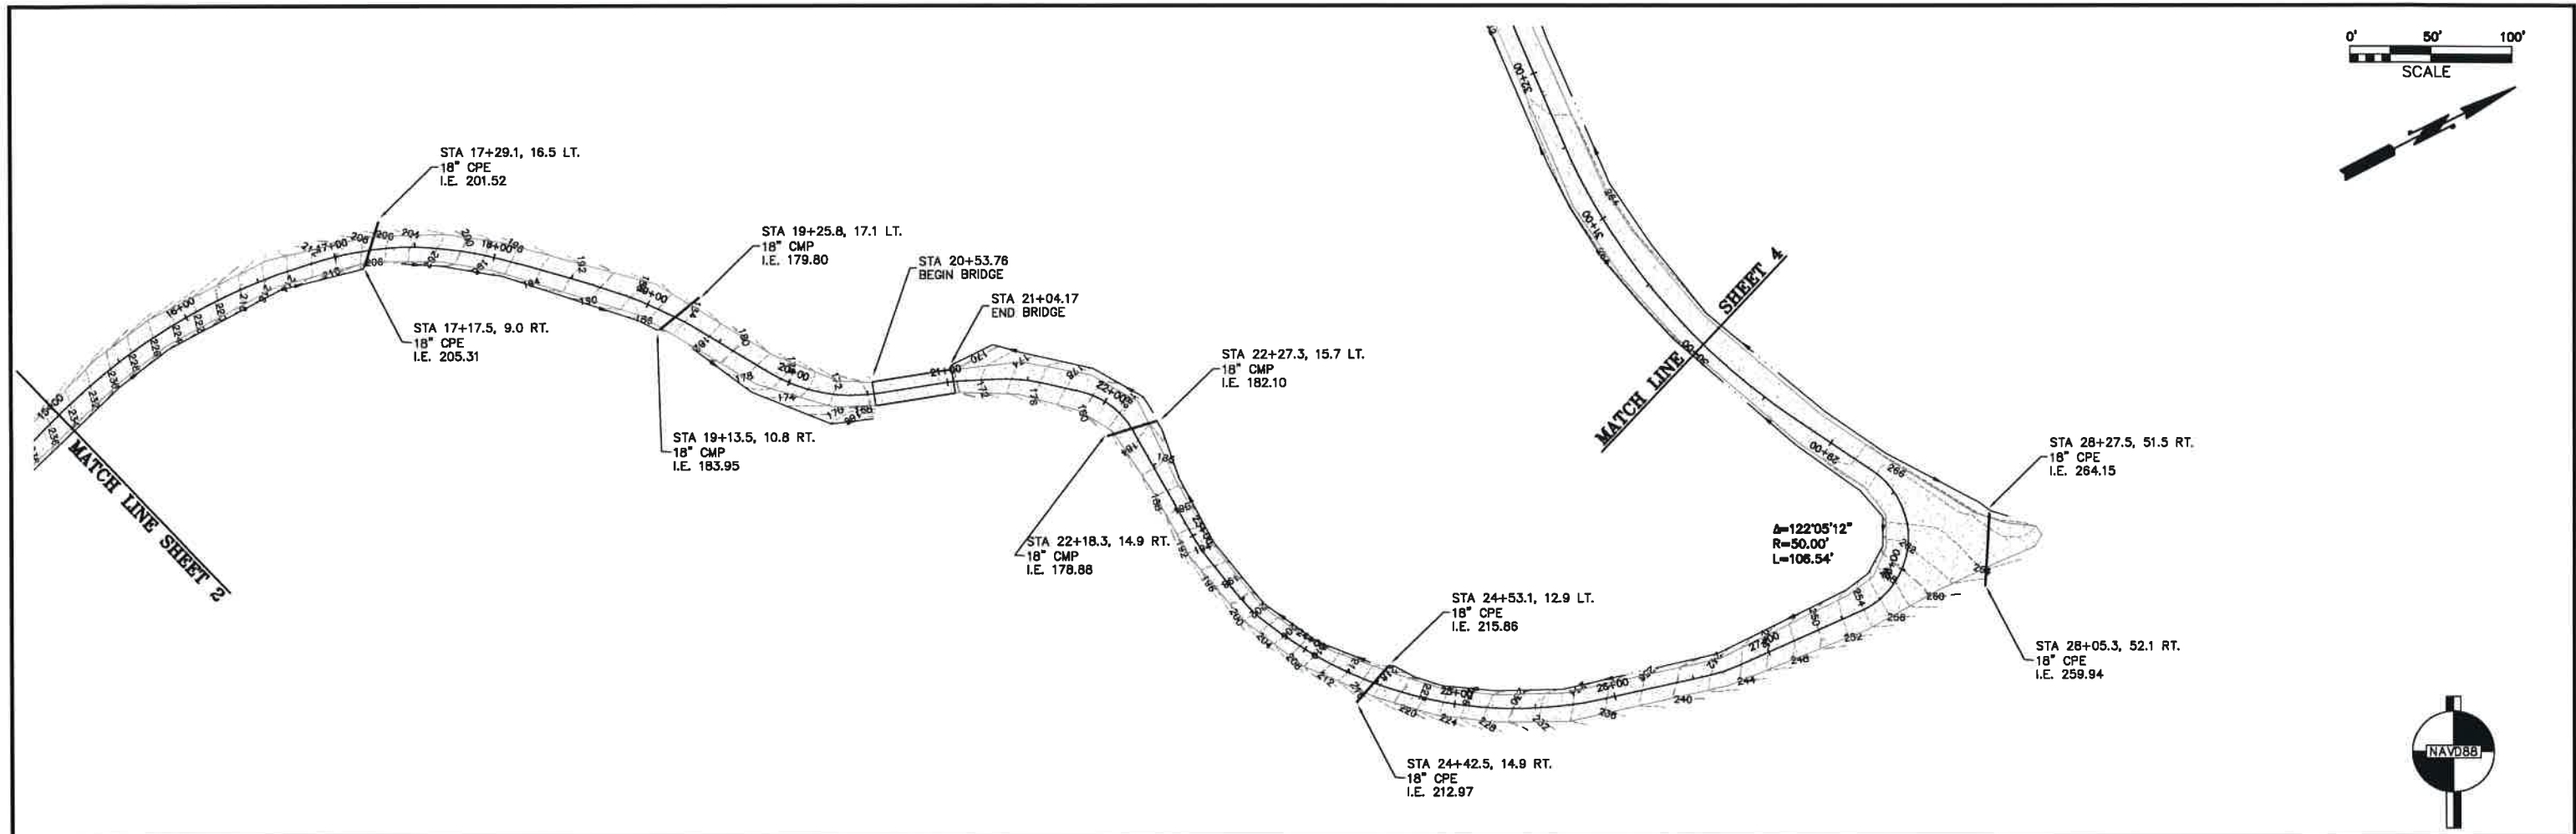

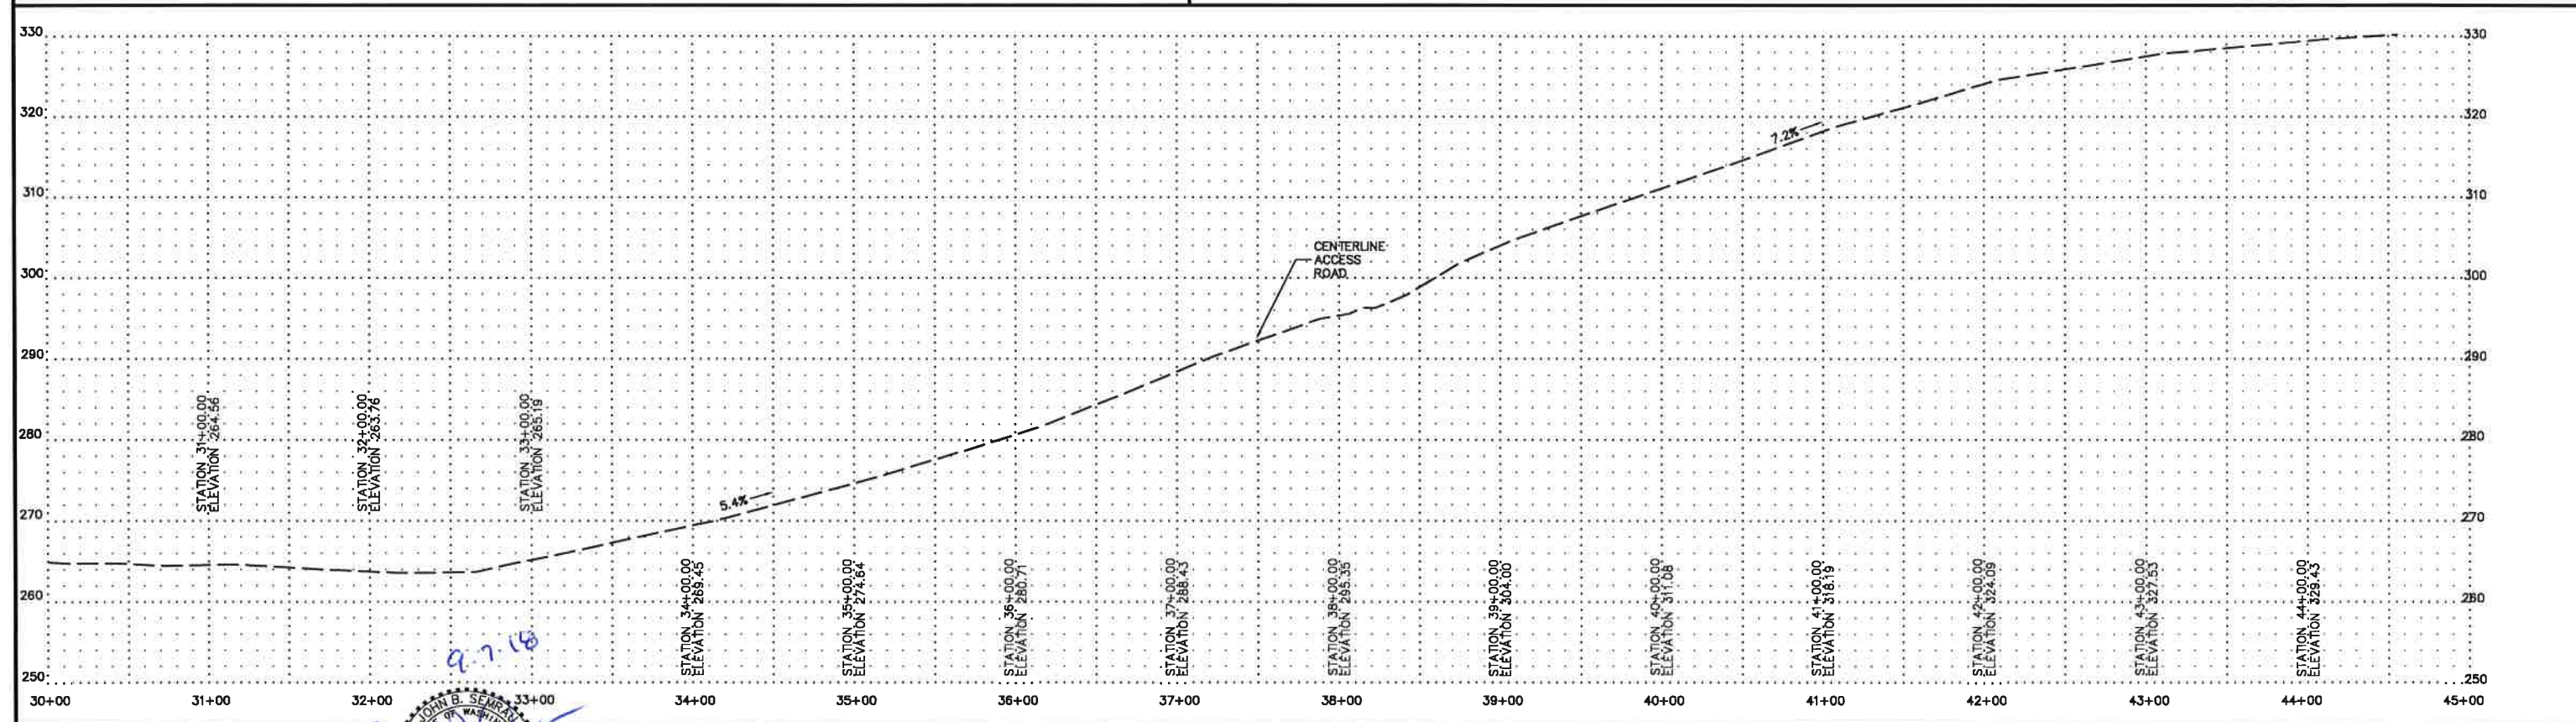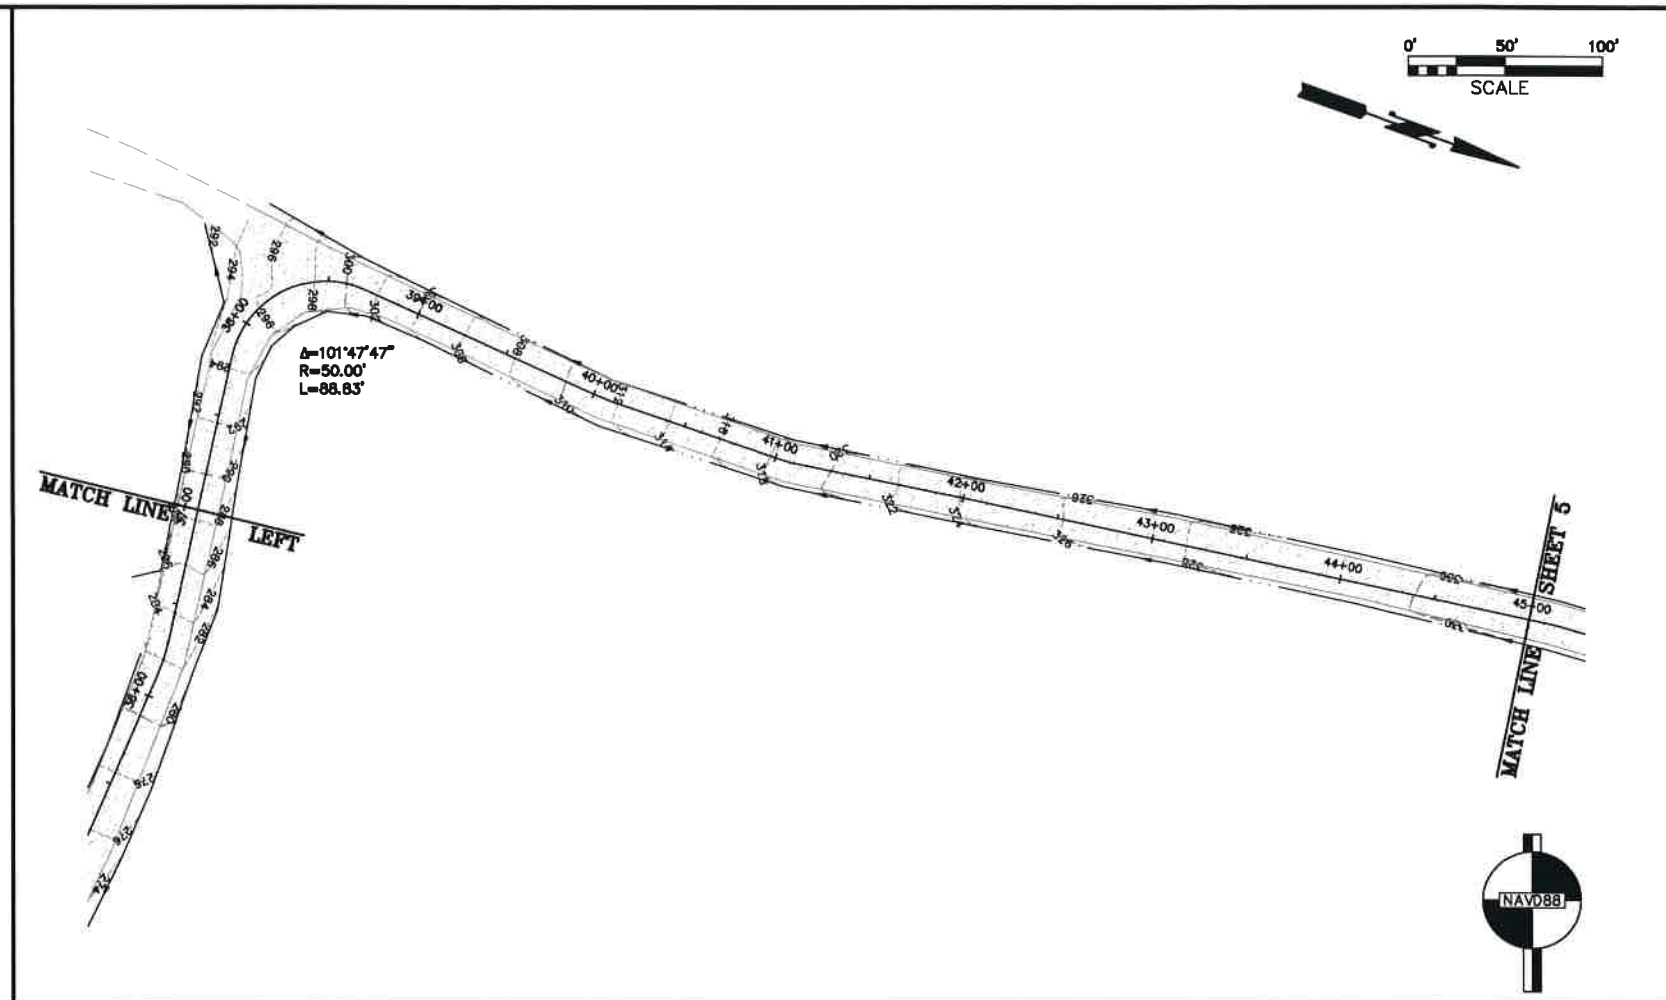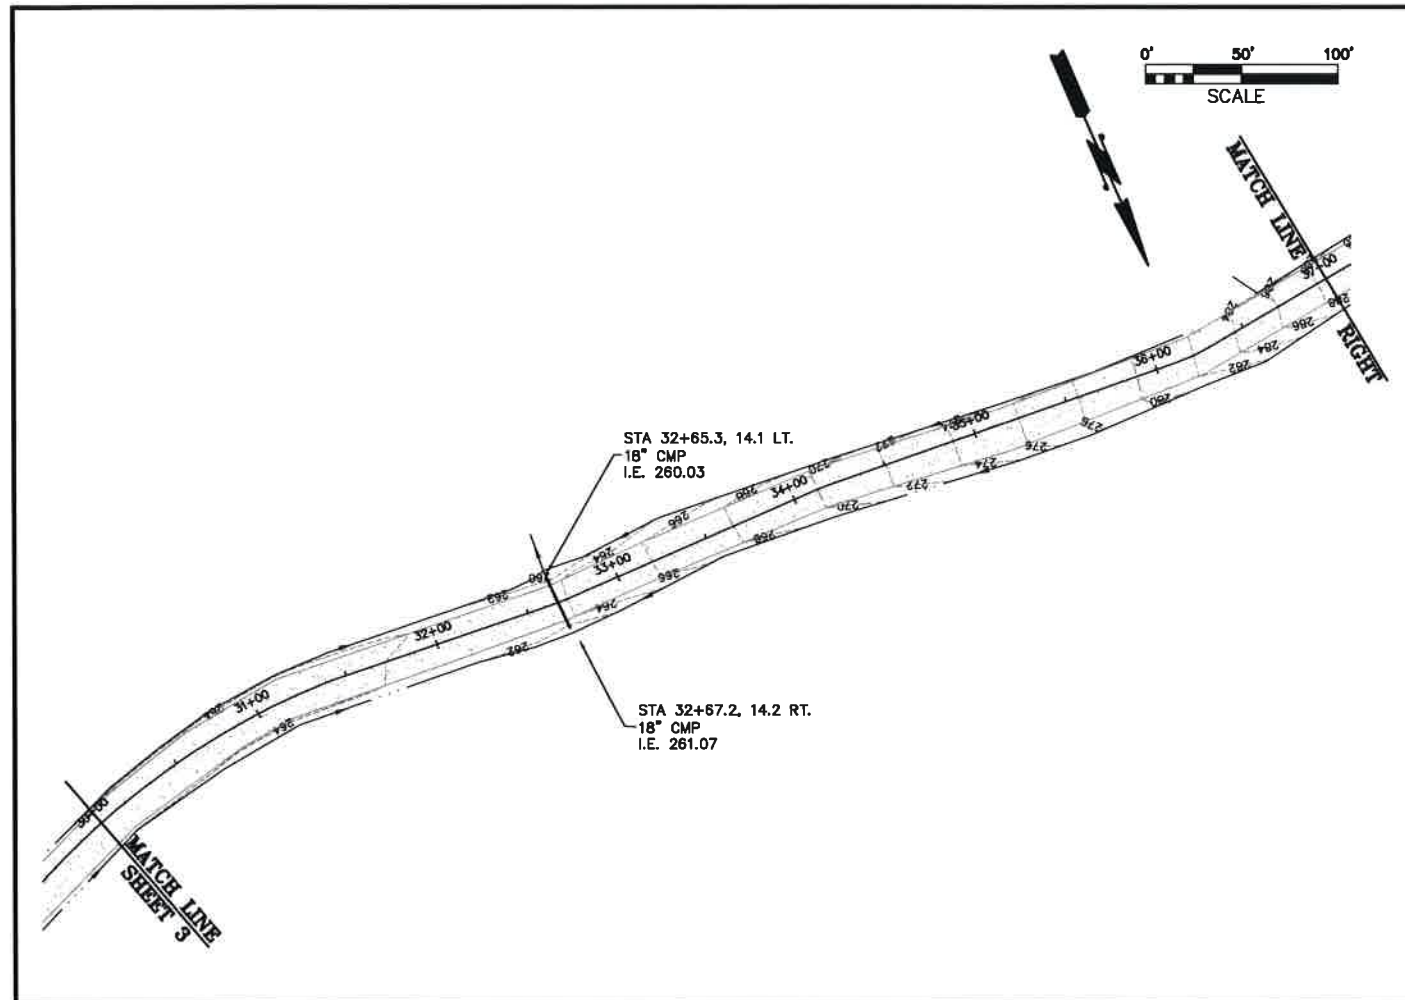

COPYRIGHT 2018
SEMRAU ENGINEERING & SURVEYING, PLLC
 CIVIL ENGINEERING • LAND SURVEYING • PLANNING
 2118 RIVERSIDE DRIVE - SUITE 208
 MOUNT VERNON, WA 98273
 360-424-9566





NO.	DATE	REVISION	BY	REV.

PLAN AND PROFILE
STATION 30+00 TO 45+00

SCALES:
 HORIZONTAL: 1" = 50'
 VERTICAL: 1" = 10'
 NOTE: IF THIS SHEET IS LESS THAN 22" x 34" THEN SHEET HAS BEEN REDUCED

GRIP ROAD GRAVEL MINE
ACCESS ROAD AS BUILT
 SEC. 27, 34, T. 36 N., SEC. 3, T. 35 N., R. 4 E., W.M.
 SKAGIT COUNTY, WASHINGTON

FIELD BK/PG: 311/34-79
 DATE: 9/04/18
 DRAWING: 5168PNP.DWG
 JOB NO.: 5166
 SHEET: 4

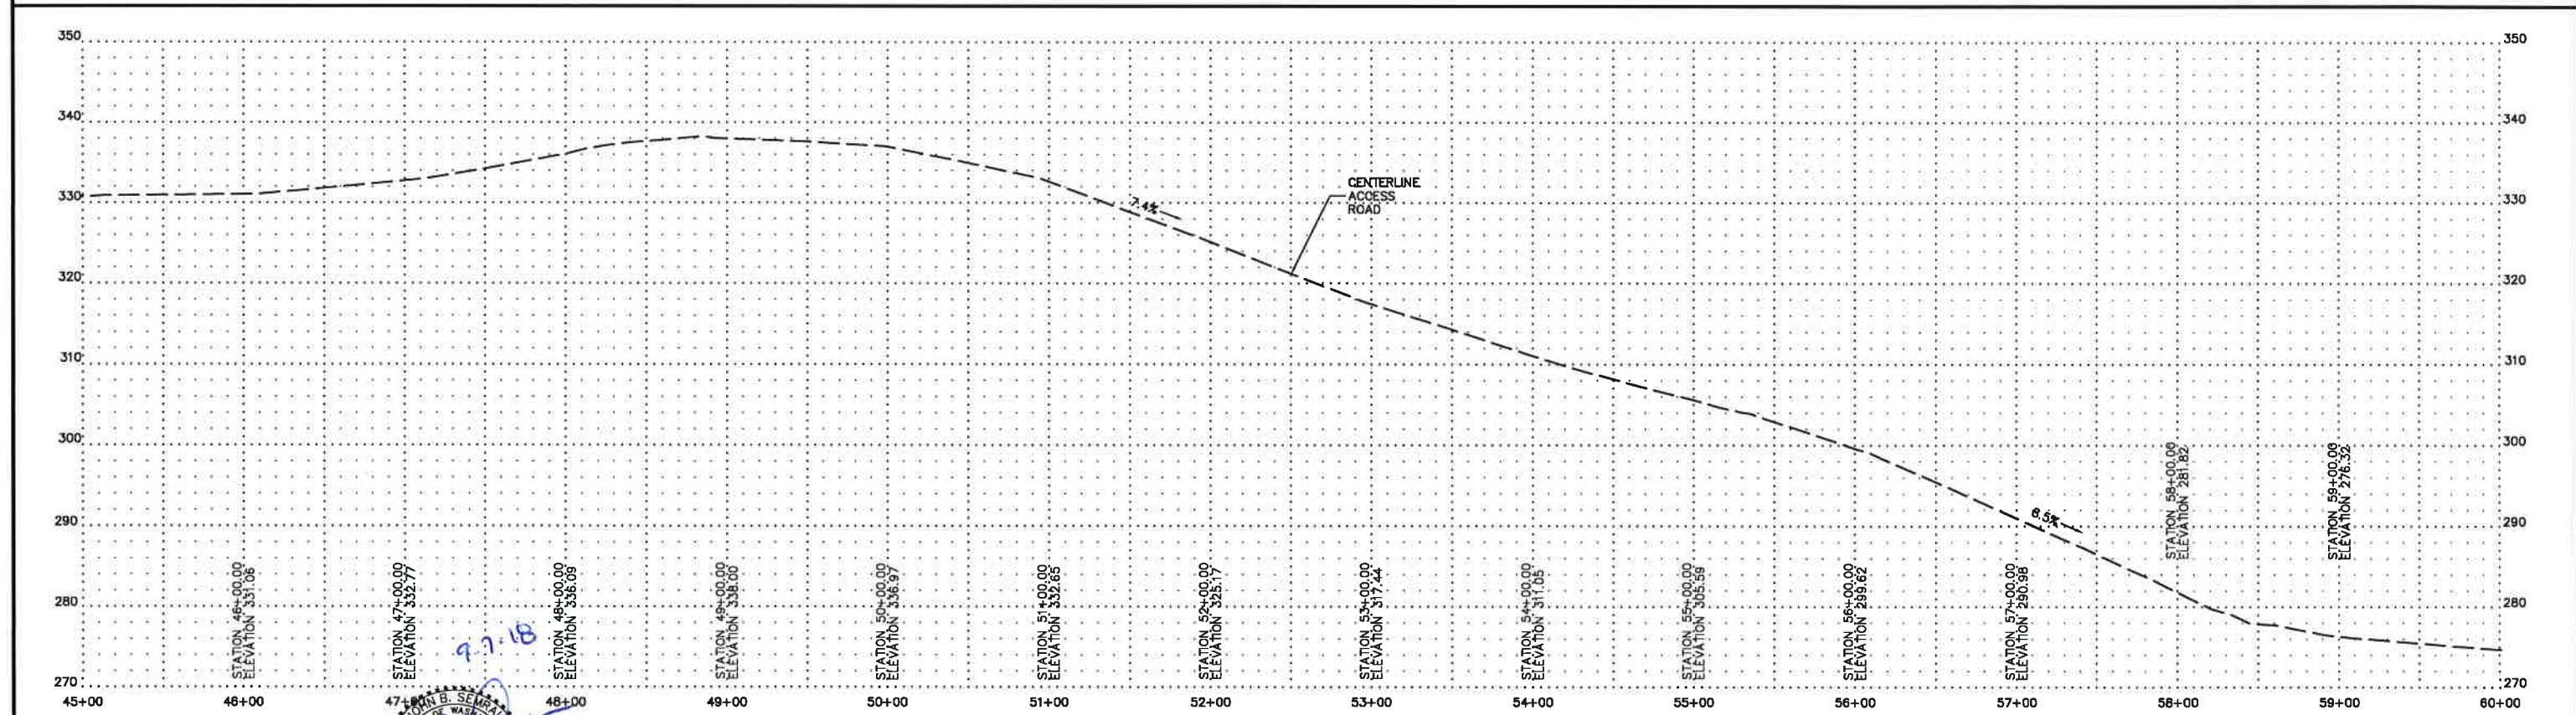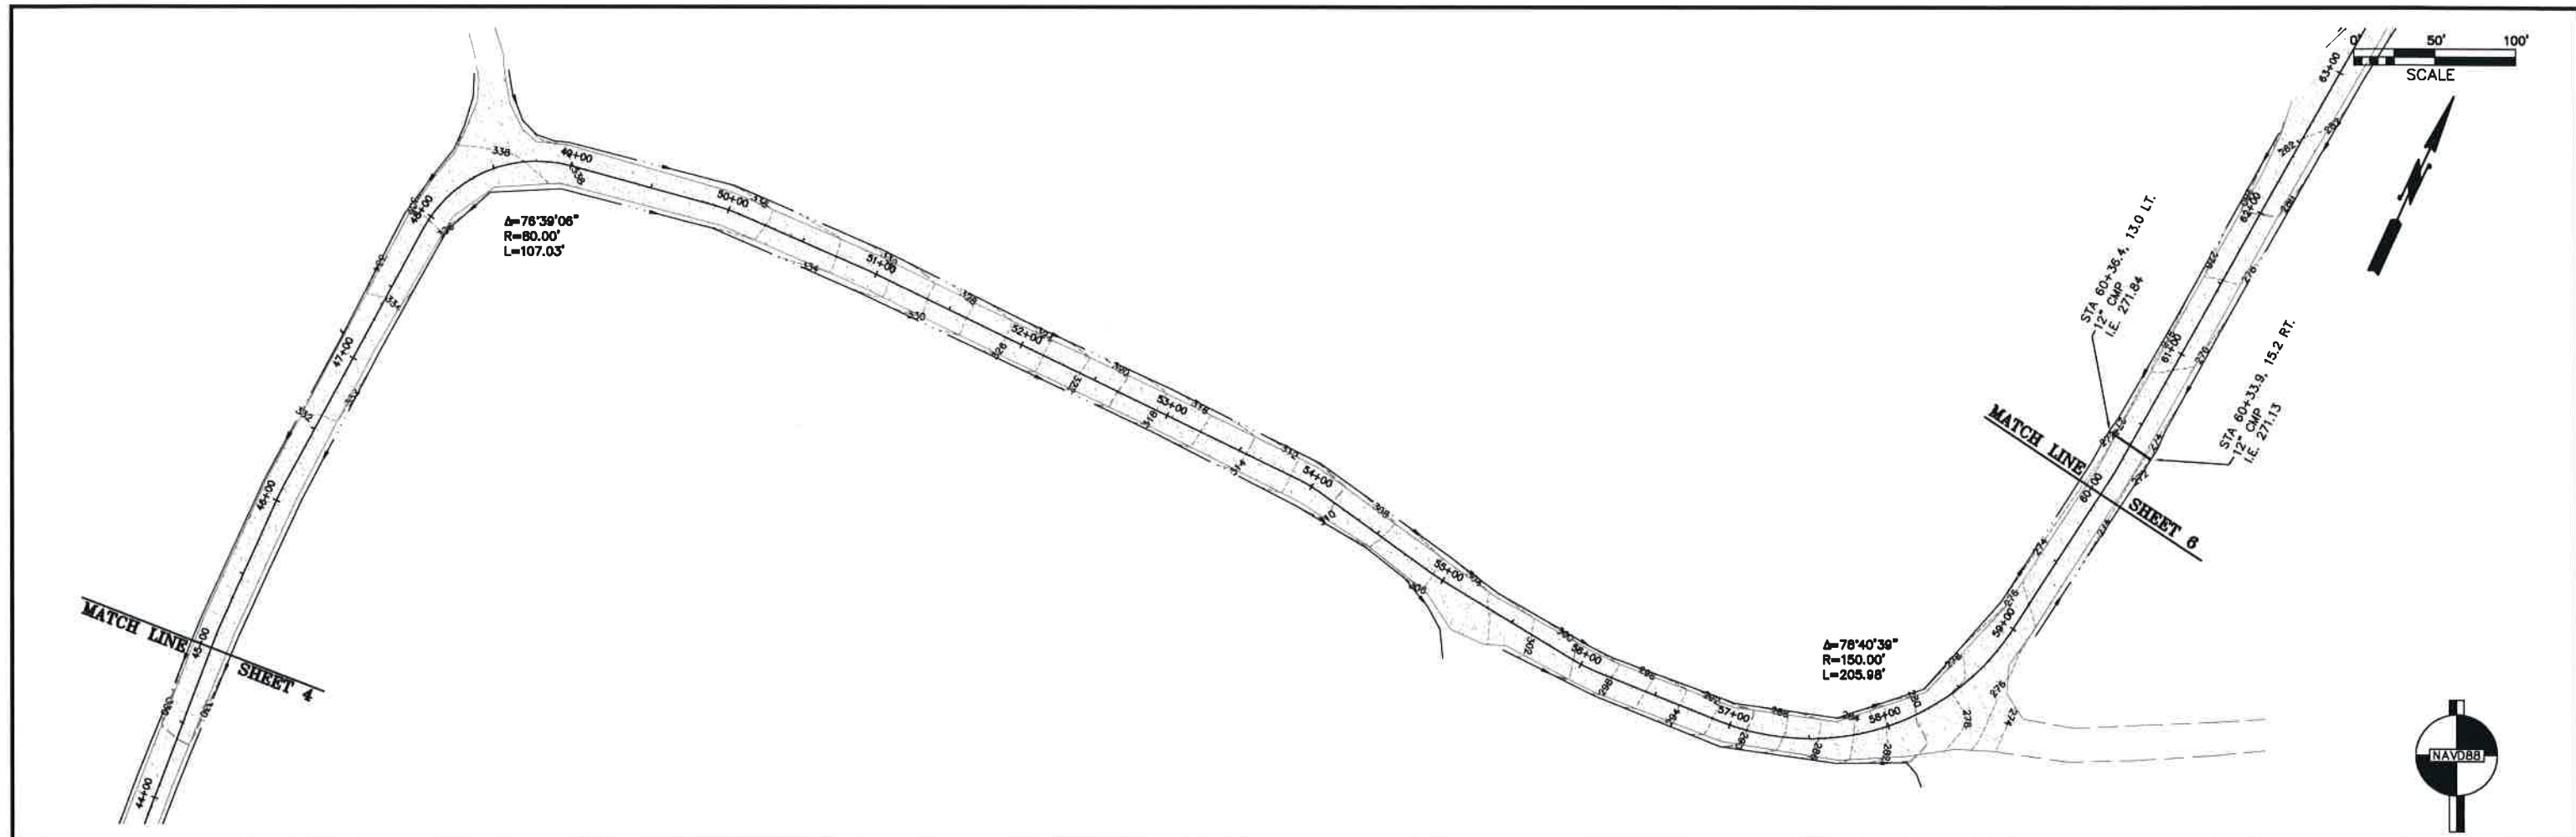

SEMPAU ENGINEERING & SURVEYING, PLLC
 CIVIL ENGINEERING • LAND SURVEYING • PLANNING
 2118 RIVERSIDE DRIVE - SUITE 208
 MOUNT VERNON, WA 98273
 360-424-9566

PLAN AND PROFILE
STATION 45+00 TO 60+00



SCALES:
 HORIZONTAL : 1" = 50'
 VERTICAL : 1" = 10'

NOTE: IF THIS SHEET IS LESS THAN 22" x 34" THEN SHEET HAS BEEN REDUCED

GRIP ROAD GRAVEL MINE
ACCESS ROAD AS BUILT
 SEC. 27, 34, T. 36 N., SEC. 3, T. 35 N., R. 4 E., W.M.
 SKAGIT COUNTY, WASHINGTON

FIELD BK/PG: 311/34-79
DATE: 9/04/18
DRAWING: 5166PNP.DWG
JOB NO.: 5166
SHEET: 5

NO.	DATE	REVISION	BY	REV.

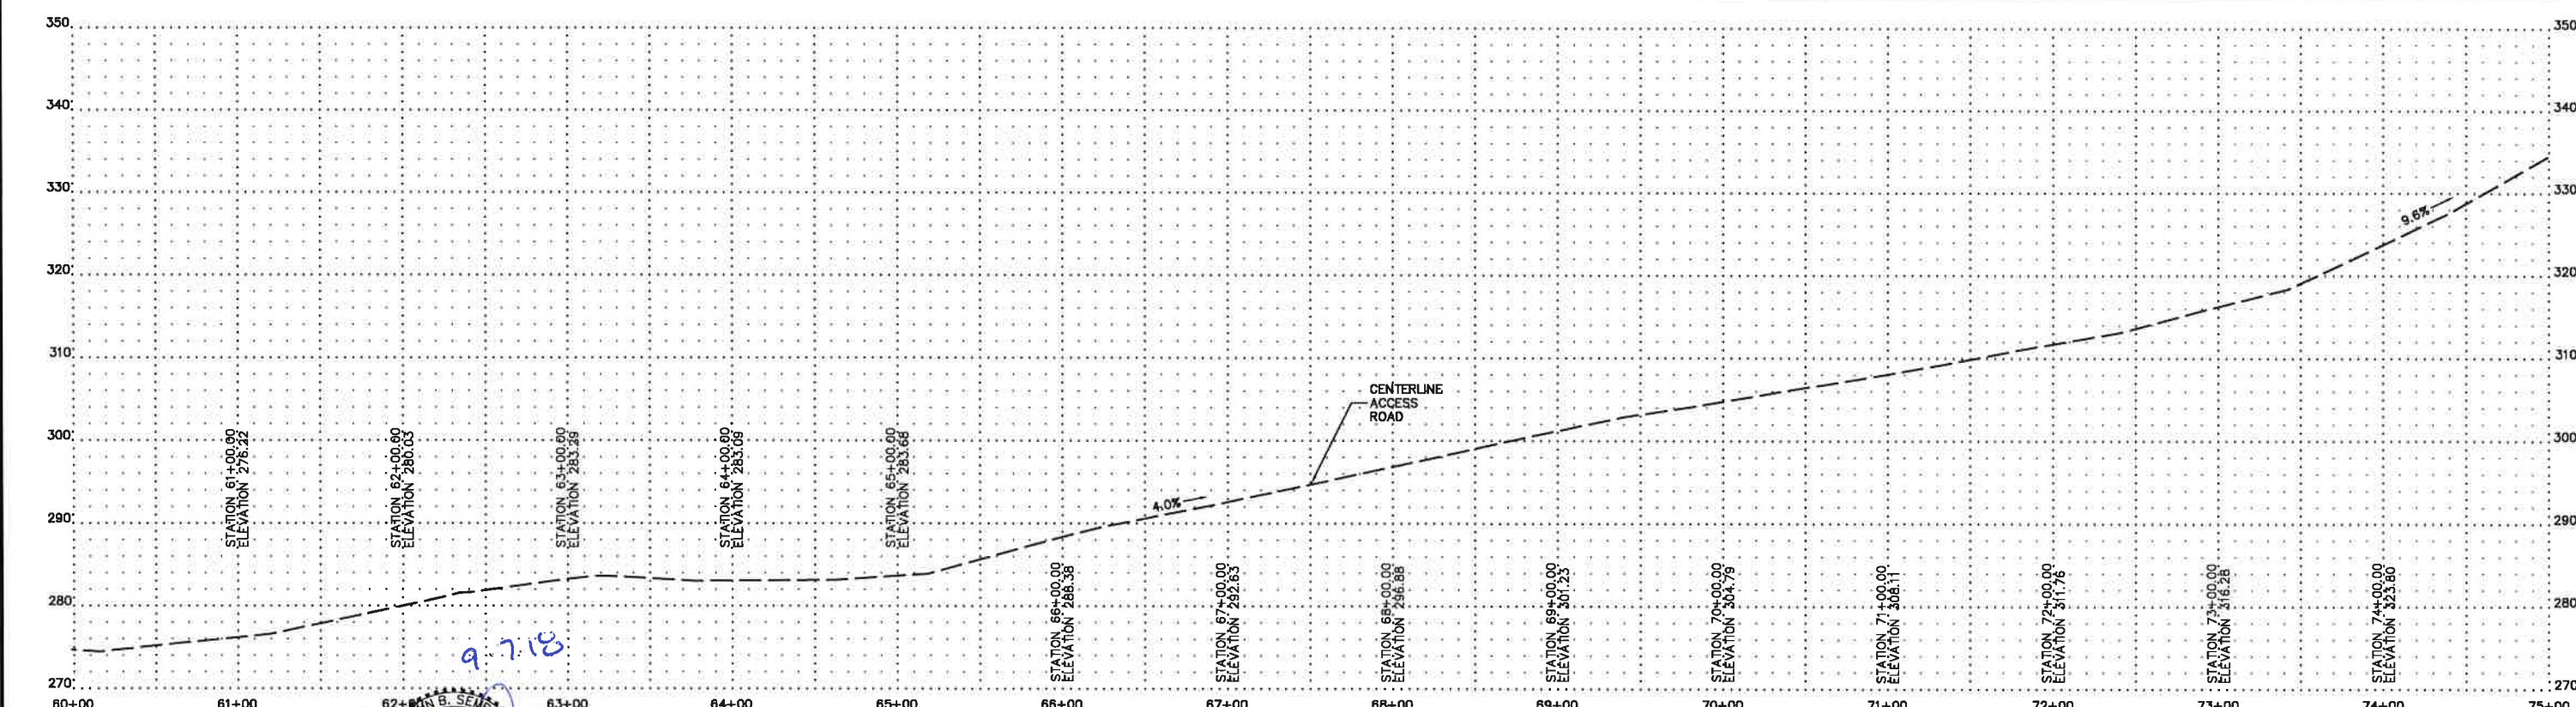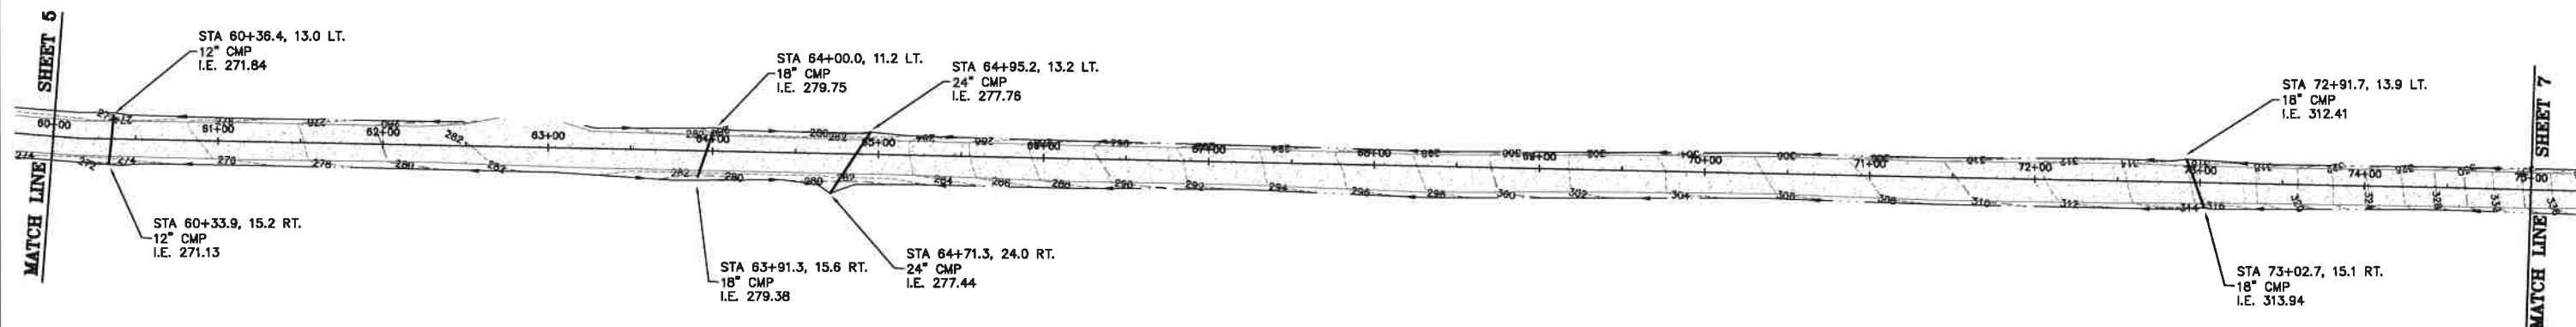

COPYRIGHT 2018
SEBRAU ENGINEERING & SURVEYING, PLLC
CIVIL ENGINEERING • LAND SURVEYING • PLANNING
2118 RIVERSIDE DRIVE - SUITE 208
MOUNT VERNON, WA 98273
360-424-9566





NO.	DATE	REVISION	BY	REV.

PLAN AND PROFILE
STATION 60+00 TO 75+00

SCALES:
HORIZONTAL: 1" = 50'
VERTICAL: 1" = 10'
NOTE: IF THIS SHEET IS LESS THAN 22" x 34" THEN SHEET HAS BEEN REDUCED

GRIP ROAD GRAVEL MINE
ACCESS ROAD AS BUILT
SEC. 27, 34, T. 36 N., SEC. 3, T. 35 N., R. 4 E., W.M.
SKAGIT COUNTY, WASHINGTON

FIELD BK/PG: 311/34-79
DATE: 9/04/18
DRAWING: 5166PNP.DWG
JOB NO.: 5166
SHEET: 6

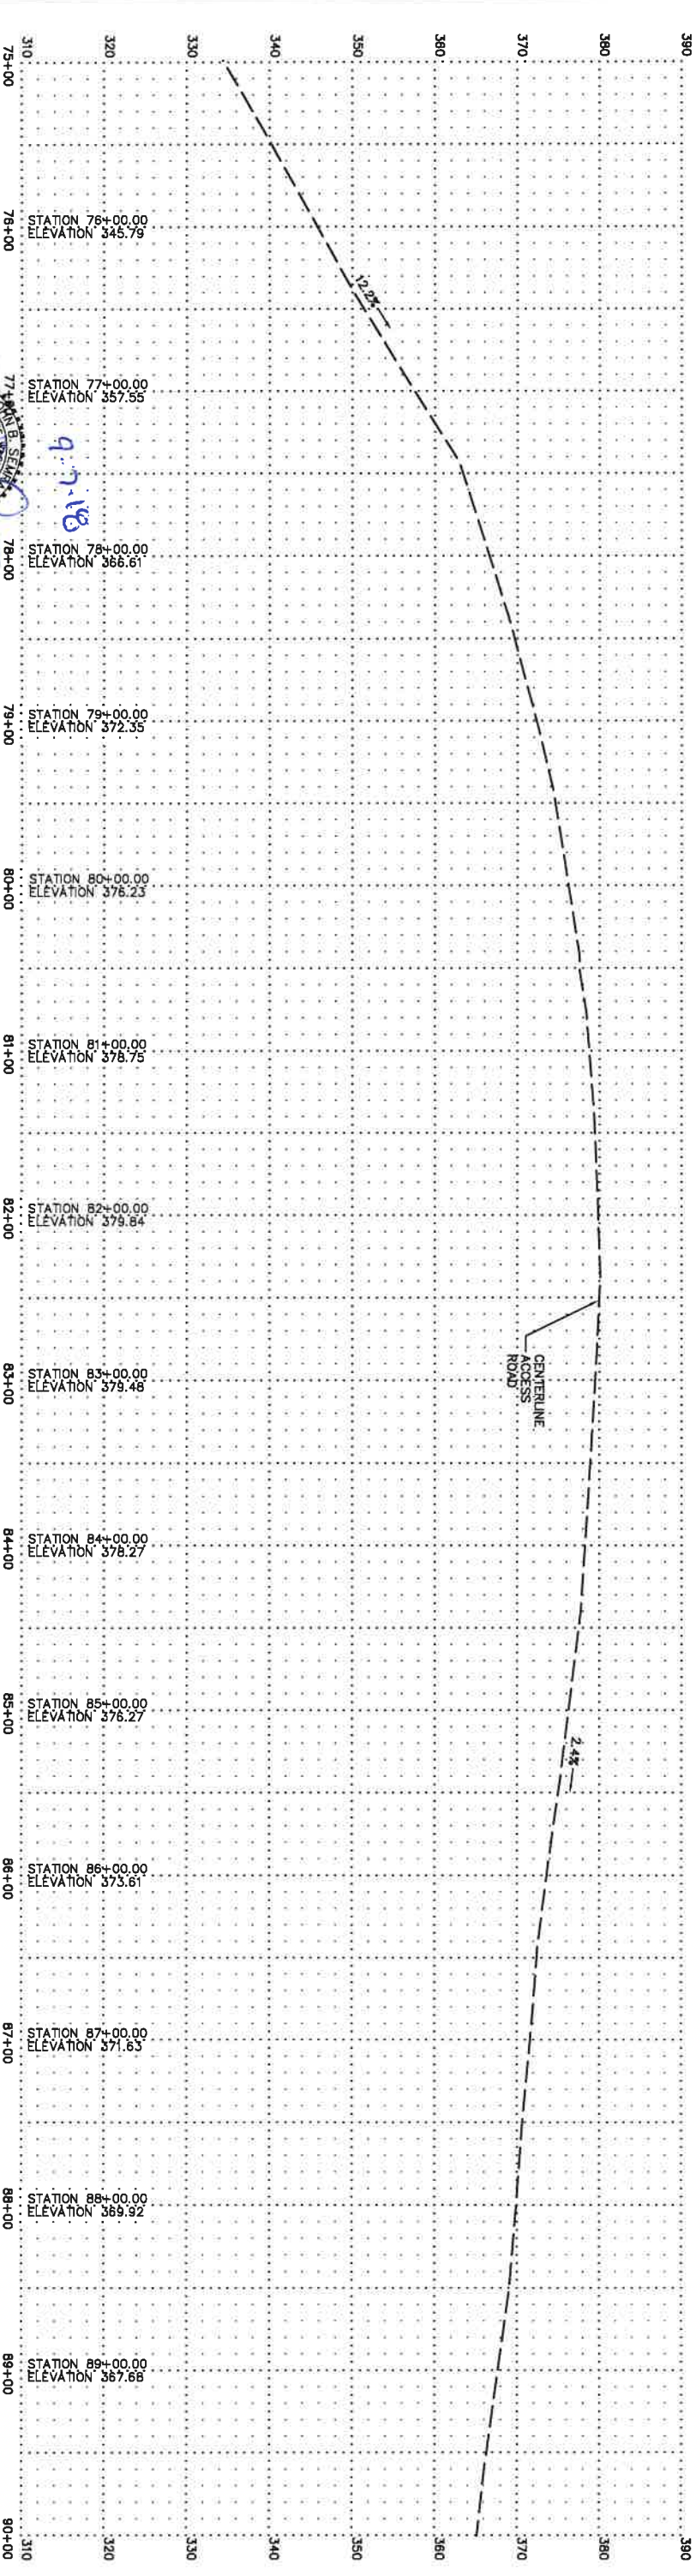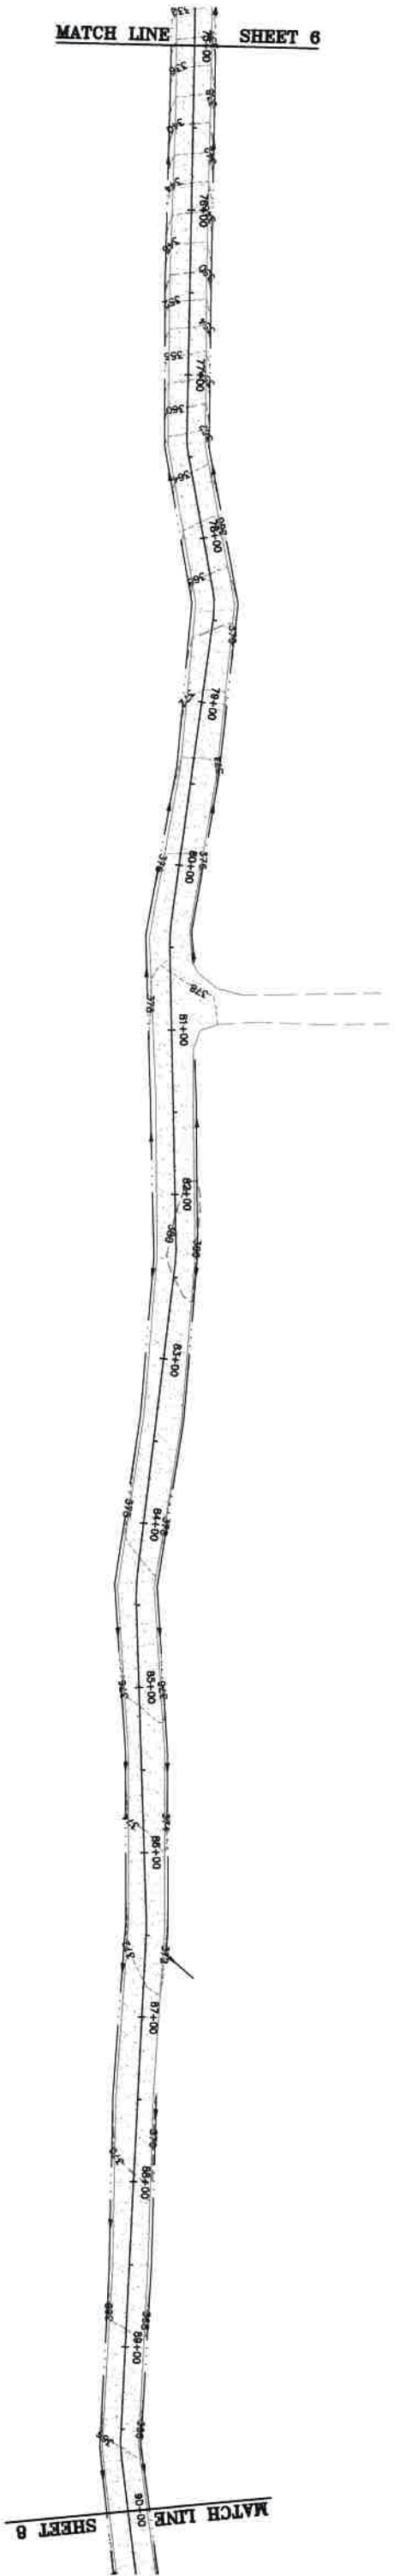

SEARAU ENGINEERING & SURVEYING, PLLC

CIVIL ENGINEERING • LAND SURVEYING • PLANNING

2118 RIVERSIDE DRIVE – SUITE 208

MOUNT VERNON, WA 98273

360-424-9566

COPYRIGHT 2018

SEARAU ENGINEERING & SURVEYING, PLLC

CIVIL ENGINEERING • LAND SURVEYING • PLANNING

2118 RIVERSIDE DRIVE – SUITE 208

MOUNT VERNON, WA 98273

360-424-9566

STATE OF WASHINGTON

REGISTERED PROFESSIONAL ENGINEER

NO. 10000

DATE

REVISION

BY

REV.

PLAN AND PROFILE

STATION 75+00 TO 90+00

SCALES:

HORIZONTAL : 1" = 50'

VERTICAL : 1" = 10'

NOTE: IF THIS SHEET IS LESS THAN 22 x 34" THEN SHEET HAS BEEN REDUCED

GRIP ROAD GRAVEL MINE

ACCESS ROAD AS BUILT

SEC. 27, 34, T. 36 N., SEC. 3, T. 35 N., R. 4 E., W.M.

SKAGIT COUNTY, WASHINGTON

FIELD BK/Pg: 311/34-79




DATE: 9/04/18

DRAWING: 5166PMP.DWG

JOB NO.: 5166

SHEET: 7

001990

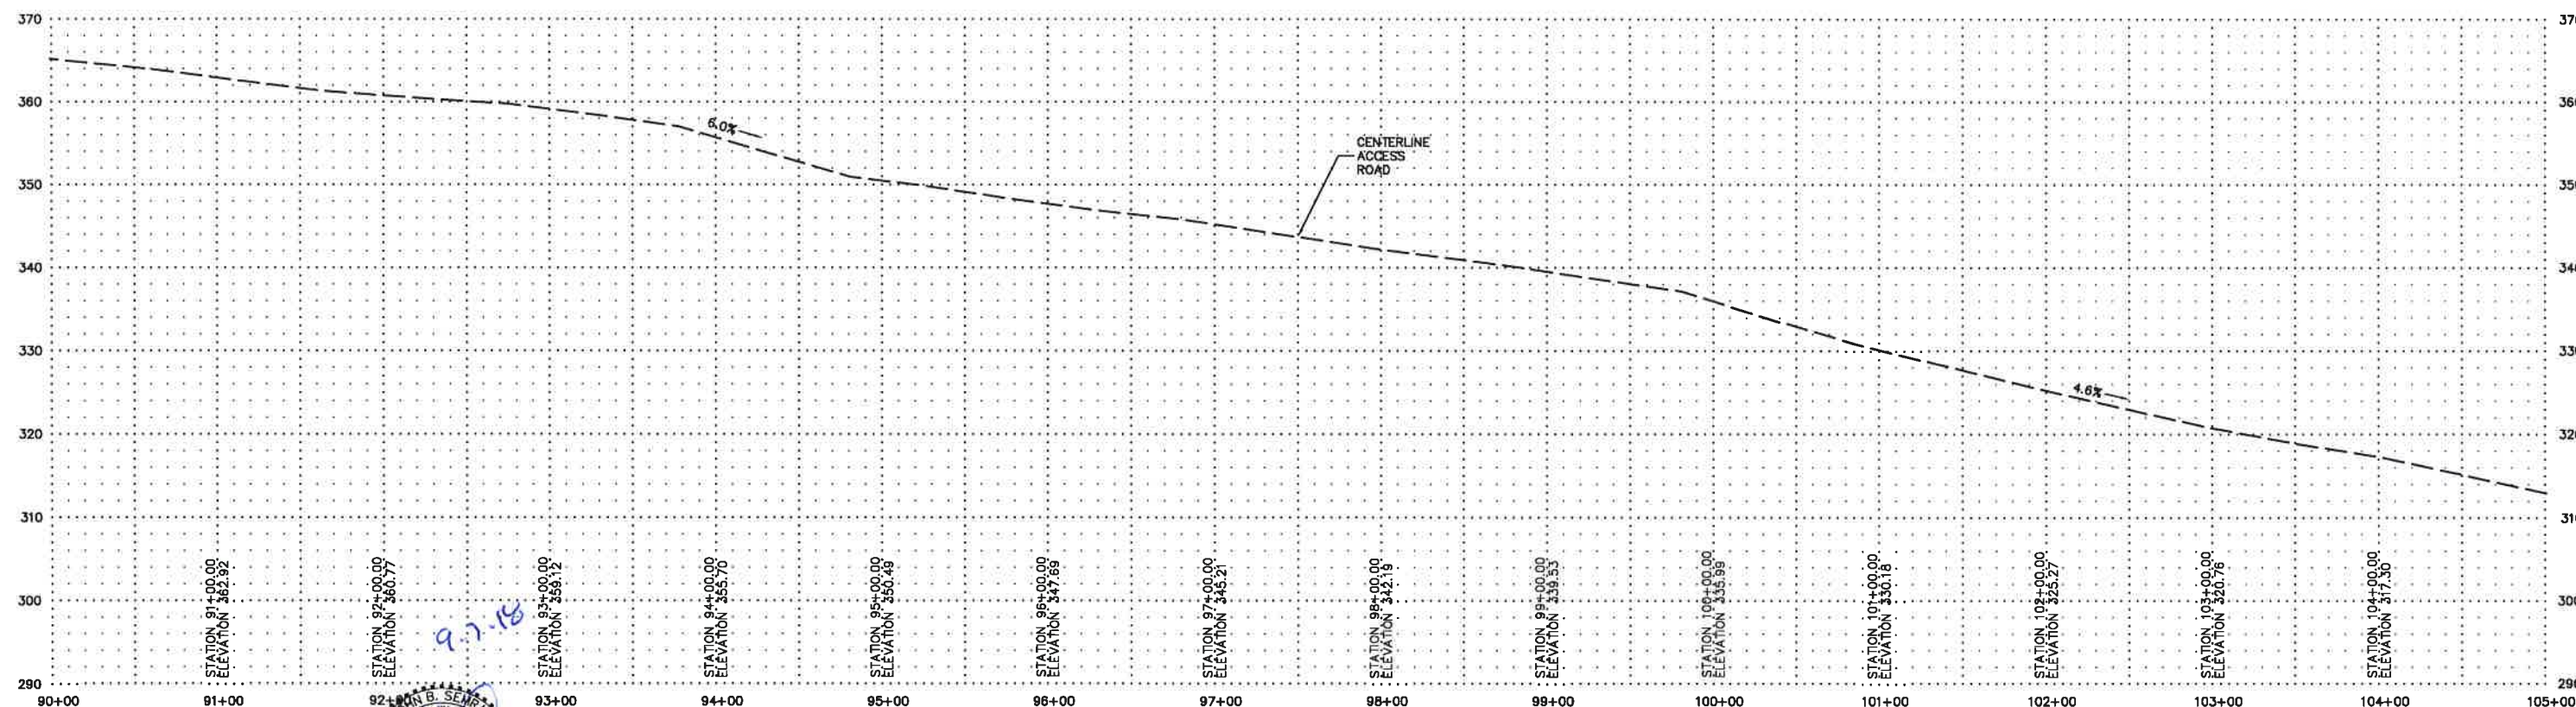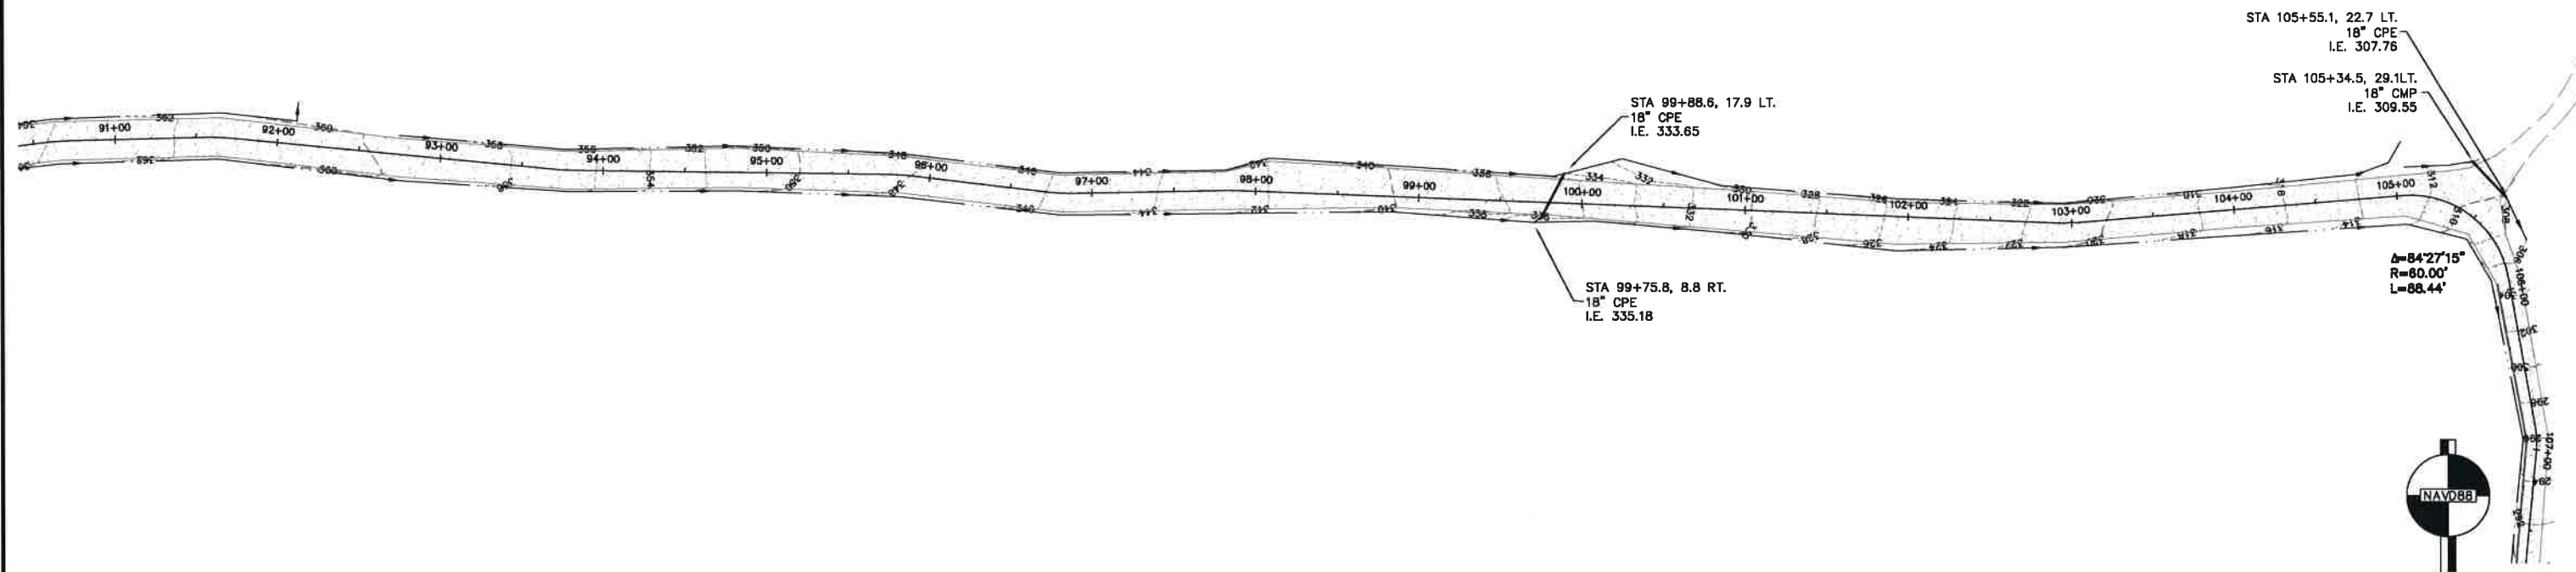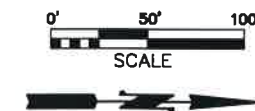

COPYRIGHT 2018
SEMRAU ENGINEERING & SURVEYING, PLLC
CIVIL ENGINEERING • LAND SURVEYING • PLANNING
2118 RIVERSIDE DRIVE - SUITE 208
MOUNT VERNON, WA 98273
360-424-9566


























NO.	DATE	REVISION	BY	REV.

PLAN AND PROFILE
STATION 90+00 TO 105+00

SCALES:
HORIZONTAL: 1" = 50'
VERTICAL: 1" = 10'
NOTE: IF THIS SHEET IS LESS
THAN 22" x 34" THEN SHEET
HAS BEEN REDUCED

GRIP ROAD GRAVEL MINE
ACCESS ROAD AS BUILT
SEC. 27, 34, T. 36 N., SEC. 3, T. 35 N., R. 4 E., W.M.
SKAGIT COUNTY, WASHINGTON

FIELD BK/PG: 311/34-79
DATE: 9/04/18
DRAWING: 5186PNP.DWG
JOB NO.: 5186
SHEET: 8

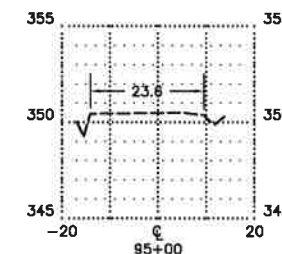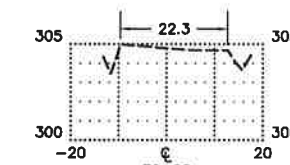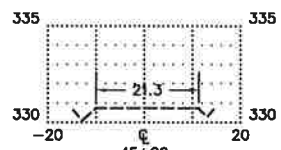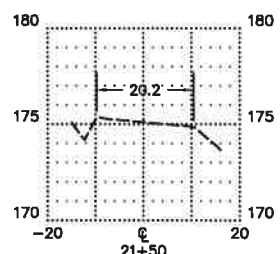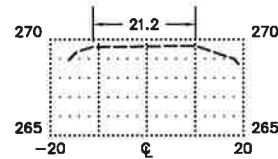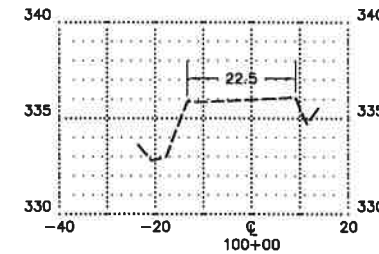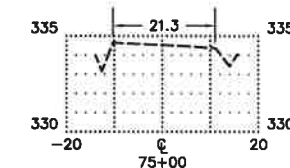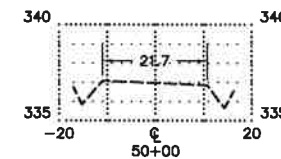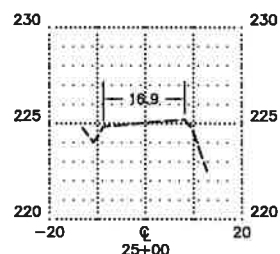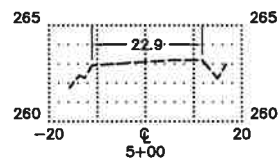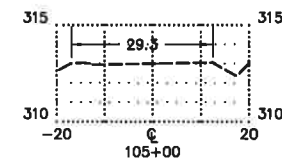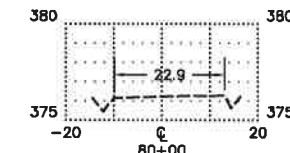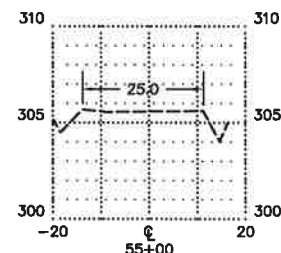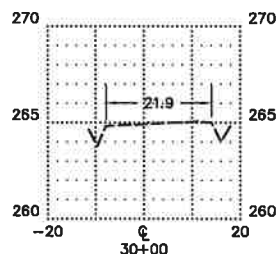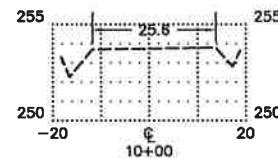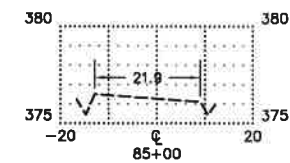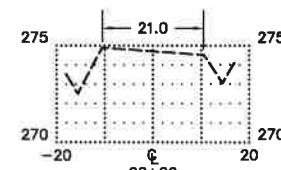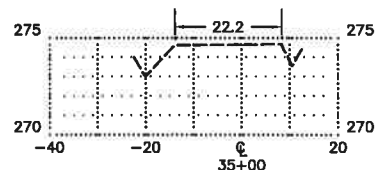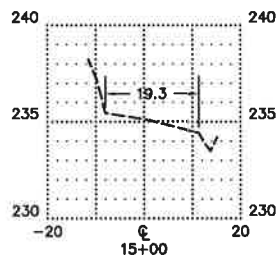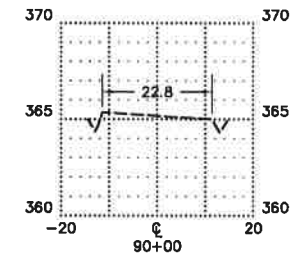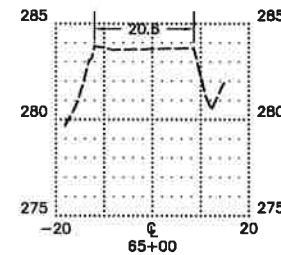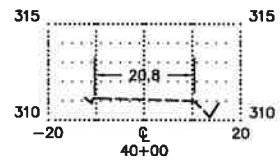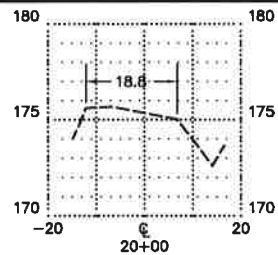

9.7.18



COPYRIGHT 2018
SEMRAU ENGINEERING & SURVEYING, PLLC
 CIVIL ENGINEERING • LAND SURVEYING • PLANNING
 2118 RIVERSIDE DRIVE - SUITE 208
 MOUNT VERNON, WA 98273
 360-424-9566

NO.	DATE	REVISION	BY	REV.


CROSS SECTIONS

SCALES:
 HORIZONTAL: 1" = 20'
 VERTICAL: 1" = 5'
 NOTE: IF THIS SHEET IS LESS THAN 22" x 34" THEN SHEET HAS BEEN REDUCED

**GRIP ROAD GRAVEL MINE
 ACCESS ROAD AS BUILT**
 SEC. 27, 34, T. 36 N., SEC. 3, T. 35 N., R. 4 E., W.M.
 SKAGIT COUNTY, WASHINGTON

FIELD BK/PG: 311/34-79
 DATE: 9/04/18
 DRAWING: 5166PNP.DWG
 JOB NO.: 5166
 SHEET: 9



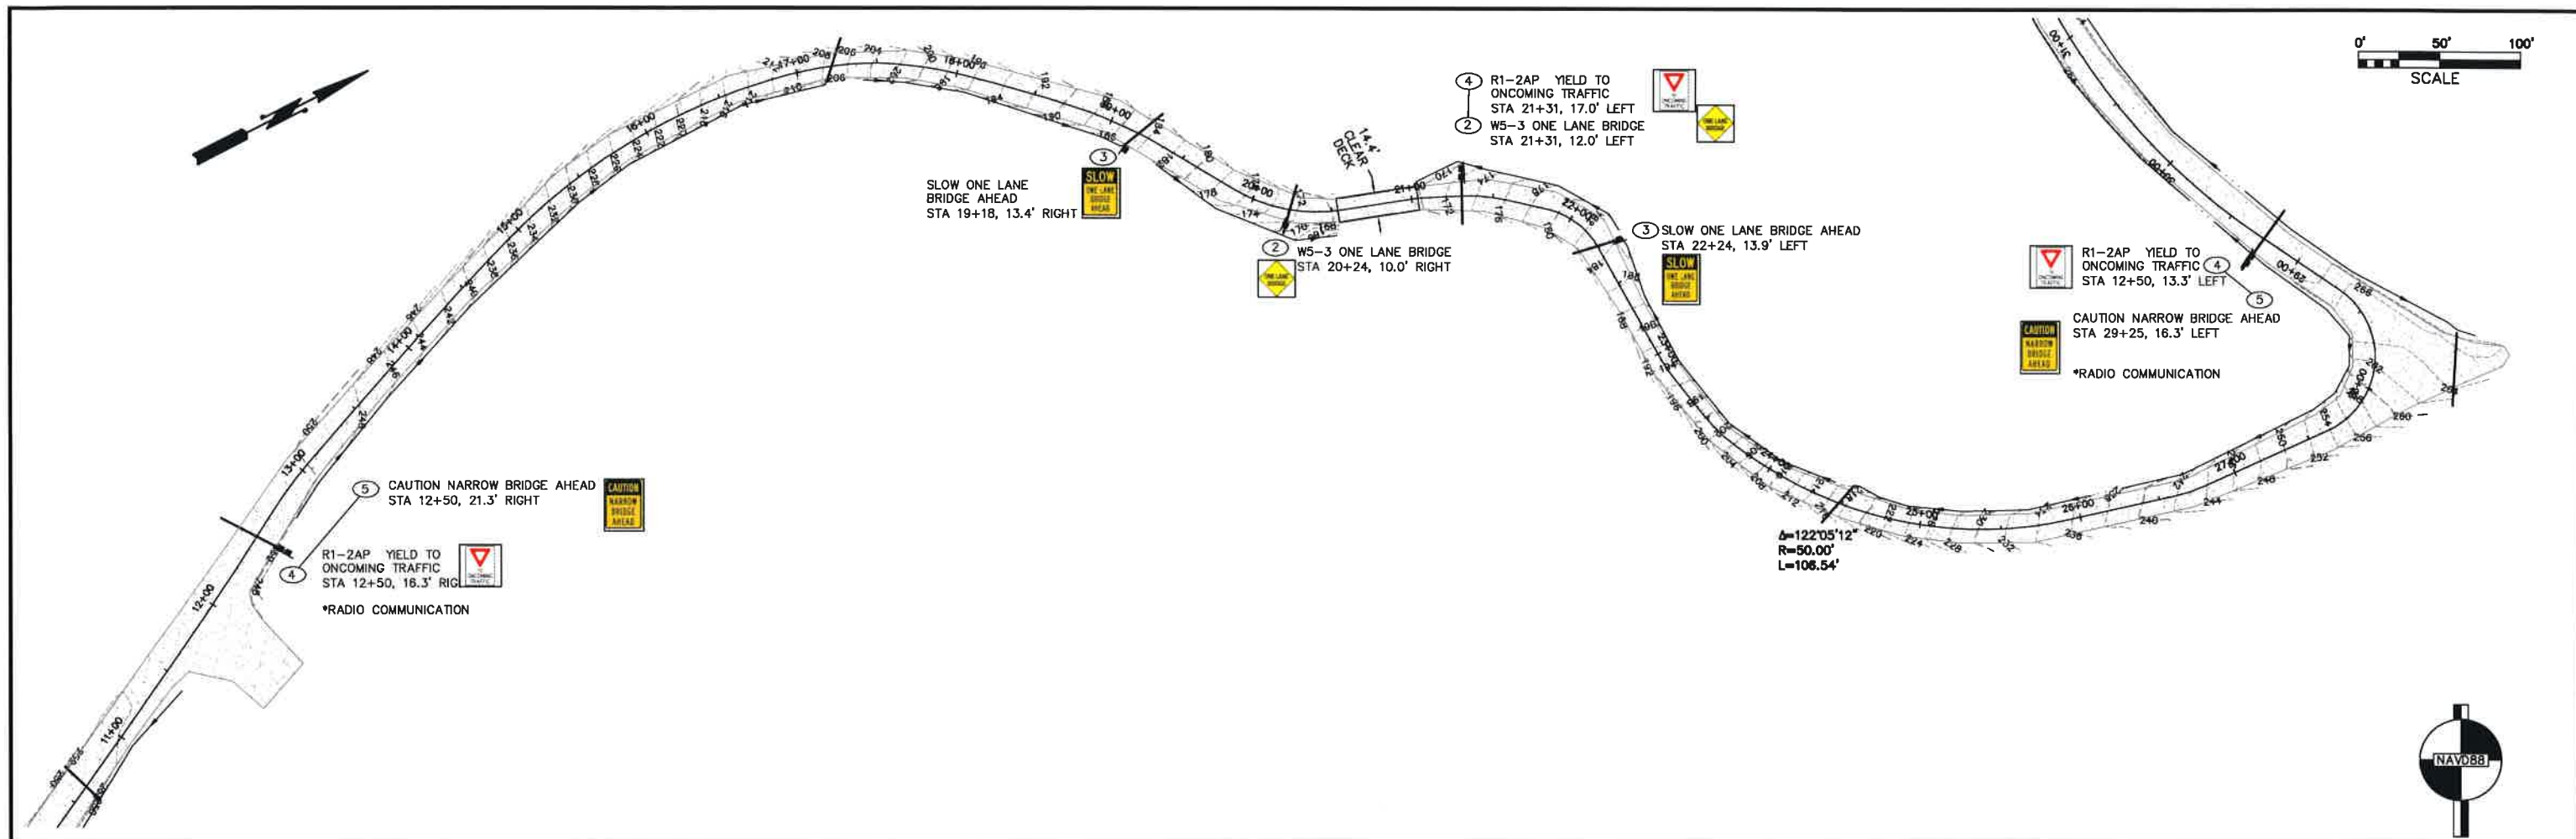

SIGN LEGEND



R1-1 STOP



W5-3 ONE LANE BRIDGE



SLOW ONE LANE BRIDGE AHEAD



R1-2AP YIELD TO ONCOMING TRAFFIC



CAUTION NARROW BRIDGE AHEAD

COPYRIGHT 2018
SEMRAU ENGINEERING & SURVEYING, PLLC
 CIVIL ENGINEERING • LAND SURVEYING • PLANNING
 2118 RIVERSIDE DRIVE - SUITE 208
 MOUNT VERNON, WA 98273
 360-424-9566



NO.	DATE	REVISION	BY	REV.

SIGNAGE PLAN STATION 15+00 TO 30+00

SCALES:
 HORIZONTAL: 1" = 50'
 VERTICAL: 1" = 10'
 NOTE: IF THIS SHEET IS LESS THAN 22" x 34" THEN SHEET HAS BEEN REDUCED

**GRIP ROAD GRAVEL MINE
 ACCESS ROAD AS BUILT**
 SEC. 27, 34, T. 36 N., SEC. 3, T. 35 N., R. 4 E., W.M.
 SKAGIT COUNTY, WASHINGTON

FIELD BK/PG: 311/34-79
 DATE: 9/13/18
 DRAWING: 5186PNP.DWG
 JOB NO.: 5186
 SHEET: 10