
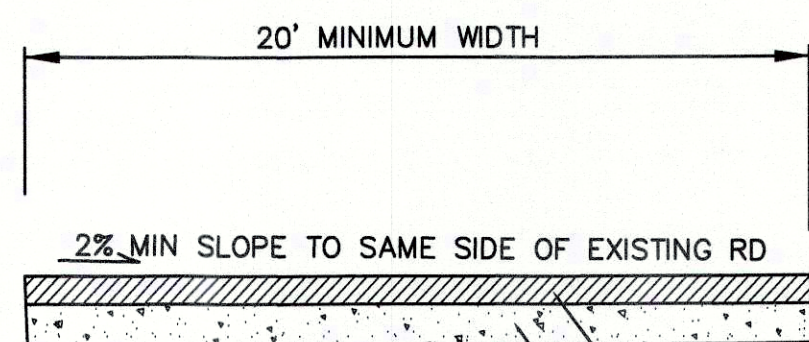
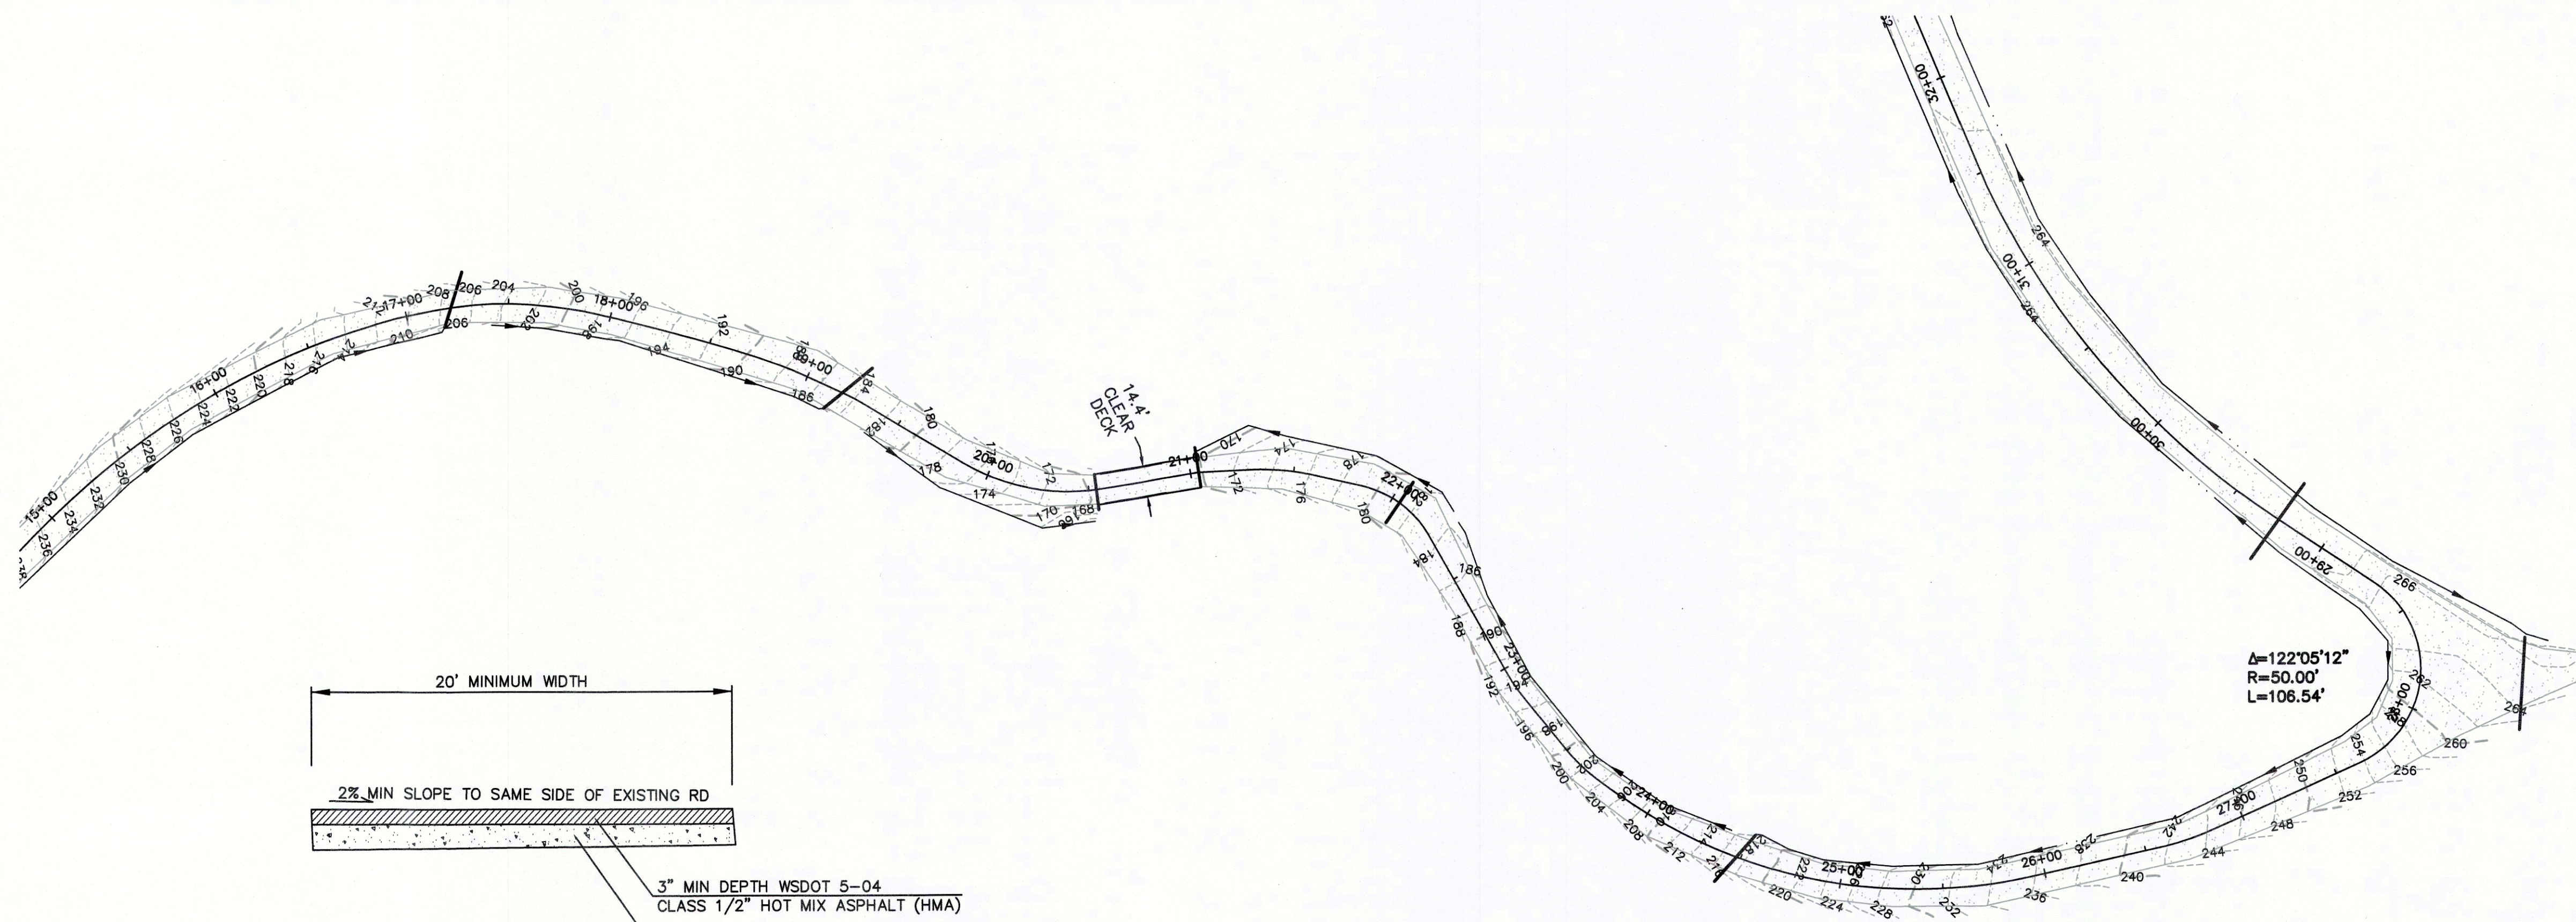


Exhibit B-69: Grip Road Access Plan, Revised Sht 3


0' 50' 100'
SCALE

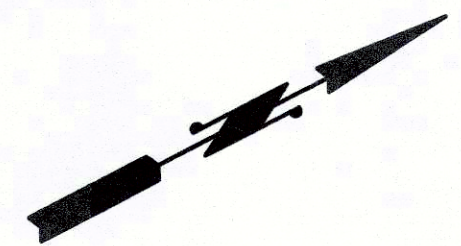

PAVING SECTION
STA 21+00 TO 26+00

(NOT TO SCALE)

3" MIN DEPTH WSDOT 5-04
CLASS 1/2" HOT MIX ASPHALT (HMA)
4" MIN DEPTH (MAY USE EXISTING) (CSBC)
CRUSHED SURFACING BASE COURSE (WSDOT 9-03.9(3))

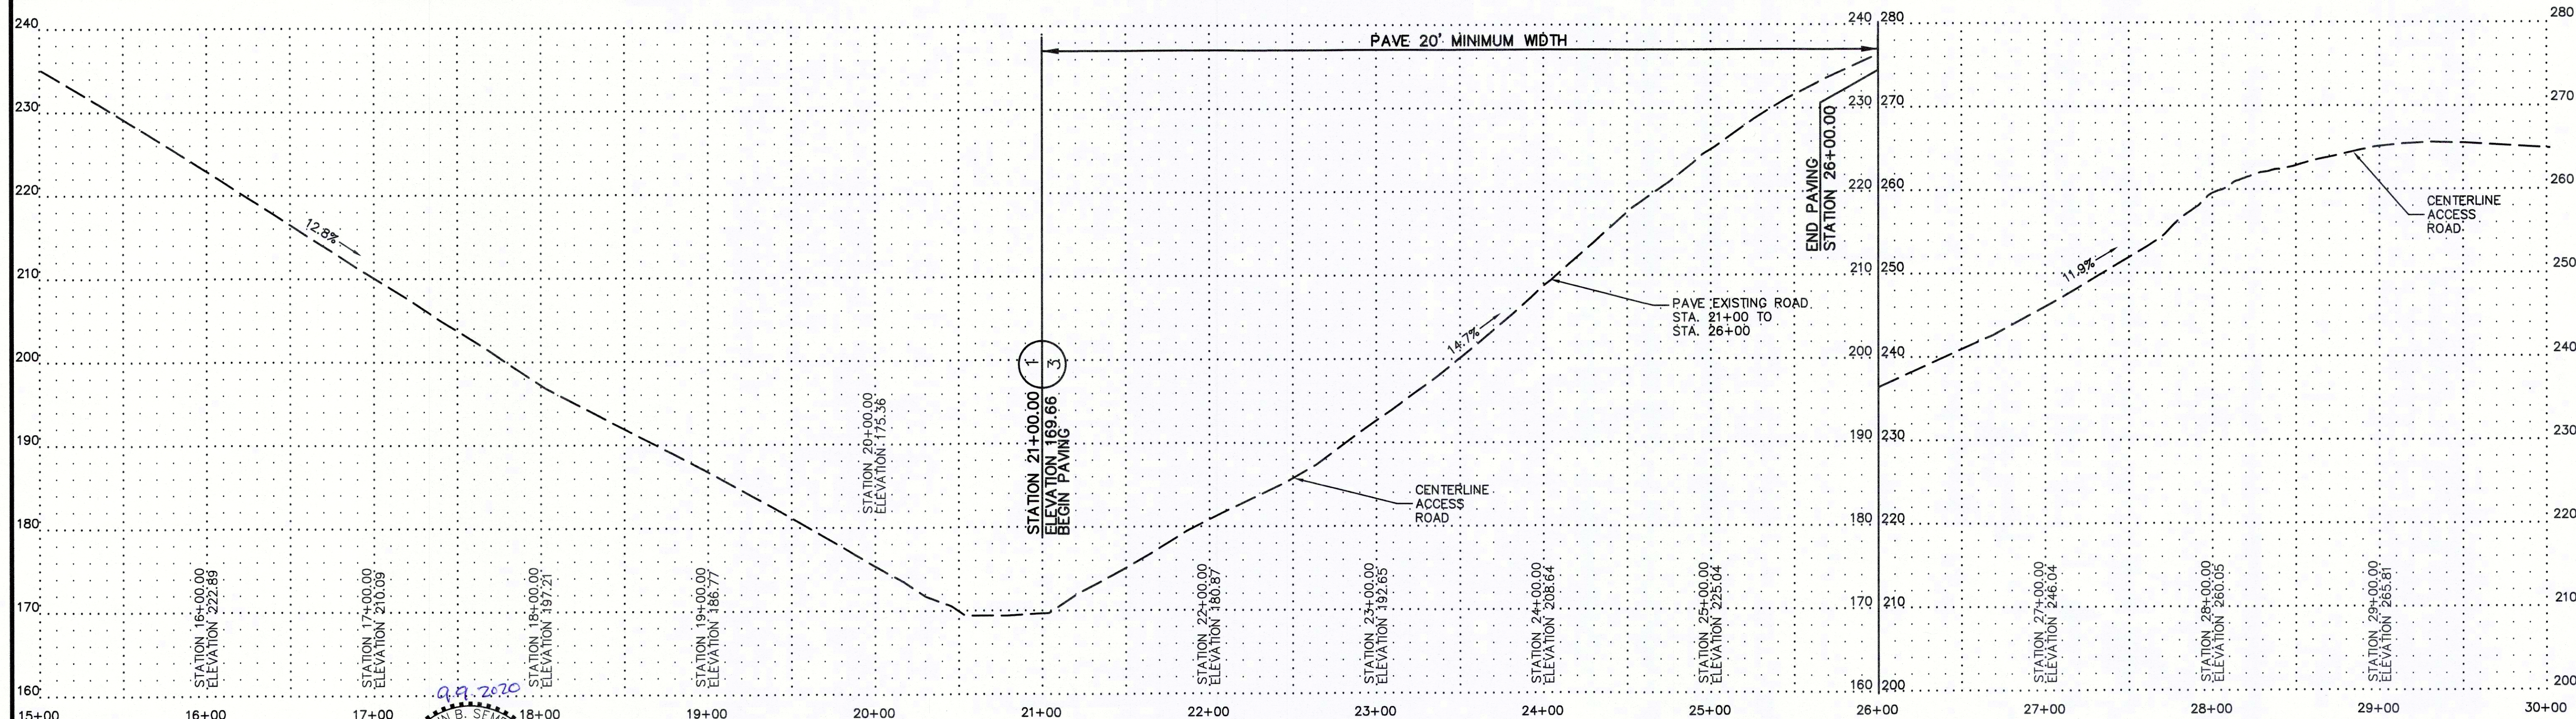

COPYRIGHT 2018
SEMRAU ENGINEERING & SURVEYING, PLLC
CIVIL ENGINEERING • LAND SURVEYING • PLANNING
2118 RIVERSIDE DRIVE - SUITE 208
MOUNT VERNON, WA 98273
360-424-9566



NO.	DATE	REVISION	BY	REV.

PLAN AND PROFILE STATION 15+00 TO 30+00

SCALES:
HORIZONTAL : 1" = 50'
VERTICAL : 1" = 10'
NOTE: IF THIS SHEET IS LESS
THAN 22" x 34" THEN SHEET
HAS BEEN REDUCED

**GRIP ROAD GRAVEL MINE
ACCESS ROAD AS BUILT**
SEC. 27, 34, T. 36 N., SEC. 3, T. 35 N., R. 4 E., W.M.
SKAGIT COUNTY, WASHINGTON

FIELD BK/PG: 311/34-79
DATE: 9/04/18
DRAWING: 5166PNP.DWG
JOB NO.: 5166
SHEET: 3