


Exhibit C-49 S-13: Markup of Applicant's
Truck diagram (Exh. 52)

KW NW Construction SDBSTSD 18'6" & DS36SA-43 15'6" 6-20Rev0

Truck Length grill to tail = 29.72 feet

$899" - 560.125" + 17.75" = 356.625"$
 $356.625" \text{ divided by } 12" = 29.72 \text{ feet}$

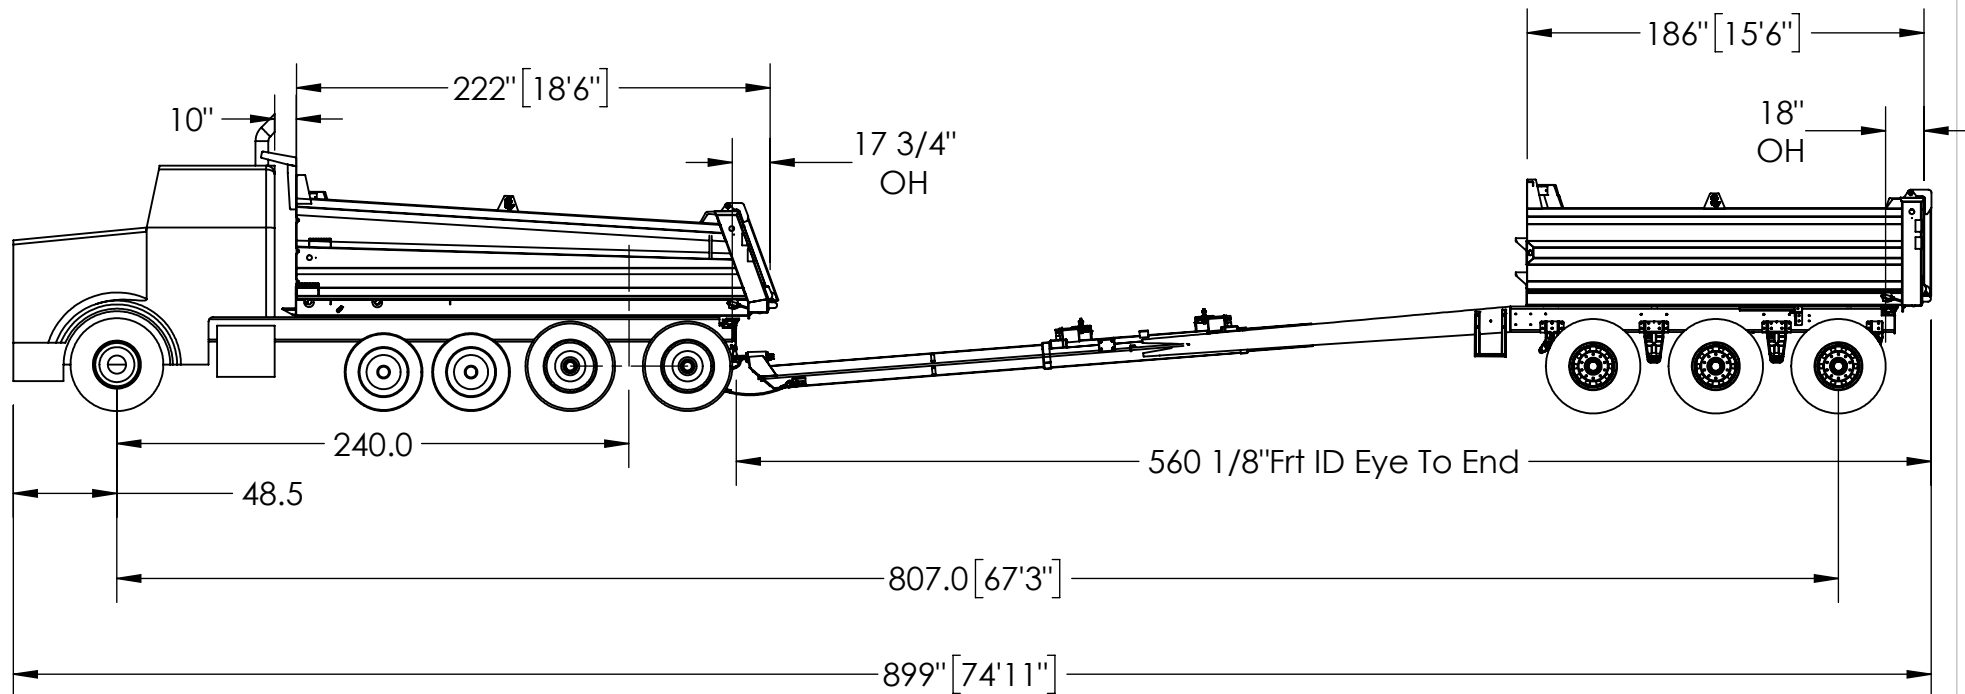


Truck Length = 30 feet

Trailer length adds 45 feet to the length fully extended
74.92' total - 30' truck length = 44.92' Build Qty

SEE SPEC FOR BODY DETAILS
See Sht 2 - truck details
See Sht 3 - trlr details

VERIFY TRUCK DIMS

KWNW		TITLE:	
PROPRIETARY AND CONFIDENTIAL		501846 Layout 12-19Rev0	
THE INFORMATION CONTAINED IN THIS DRAWING IS THE SOLE PROPERTY OF OSW Equipment & Repair, Inc. ANY REPRODUCTION IN PART OR AS A WHOLE WITHOUT THE WRITTEN PERMISSION OF OSW Equipment & Repair, Inc. IS PROHIBITED.		SIZE	REV
DO NOT SCALE DRAWING		A	0
SCALE: 1:90		12/26/2019	SHEET 1 OF 3

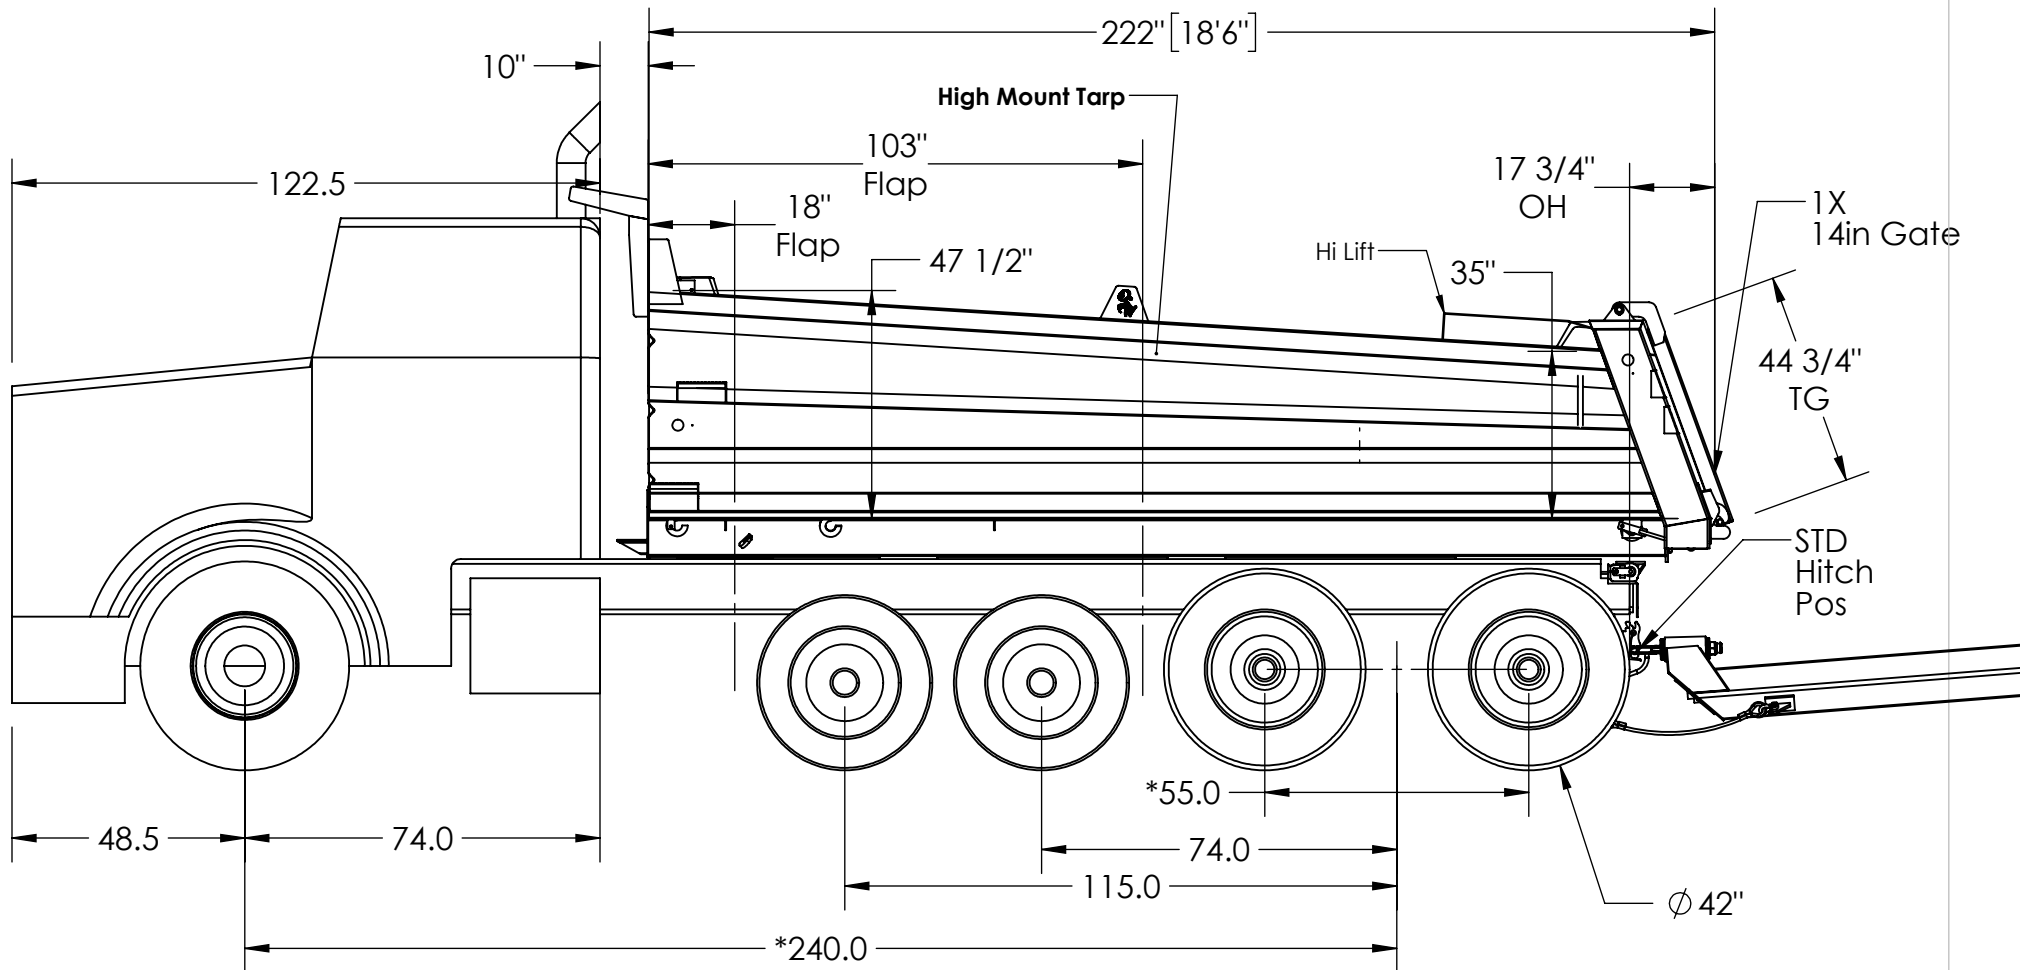

Build Qty		KWNW		
PROPRIETARY AND CONFIDENTIAL THE INFORMATION CONTAINED IN THIS DRAWING IS THE SOLE PROPERTY OF OSW Equipment & Repair, Inc. ANY REPRODUCTION IN PART OR AS A WHOLE WITHOUT THE WRITTEN PERMISSION OF OSW Equipment & Repair, Inc. IS PROHIBITED.		TITLE:		
		SIZE A	DWG. NO. 501846 Layout 12-19Rev0	REV
DO NOT SCALE DRAWING		SCALE: 1:40	12/26/2019	SHEET 2 OF 3

009266

5


4

3


2

1

See SPEC for Body Details

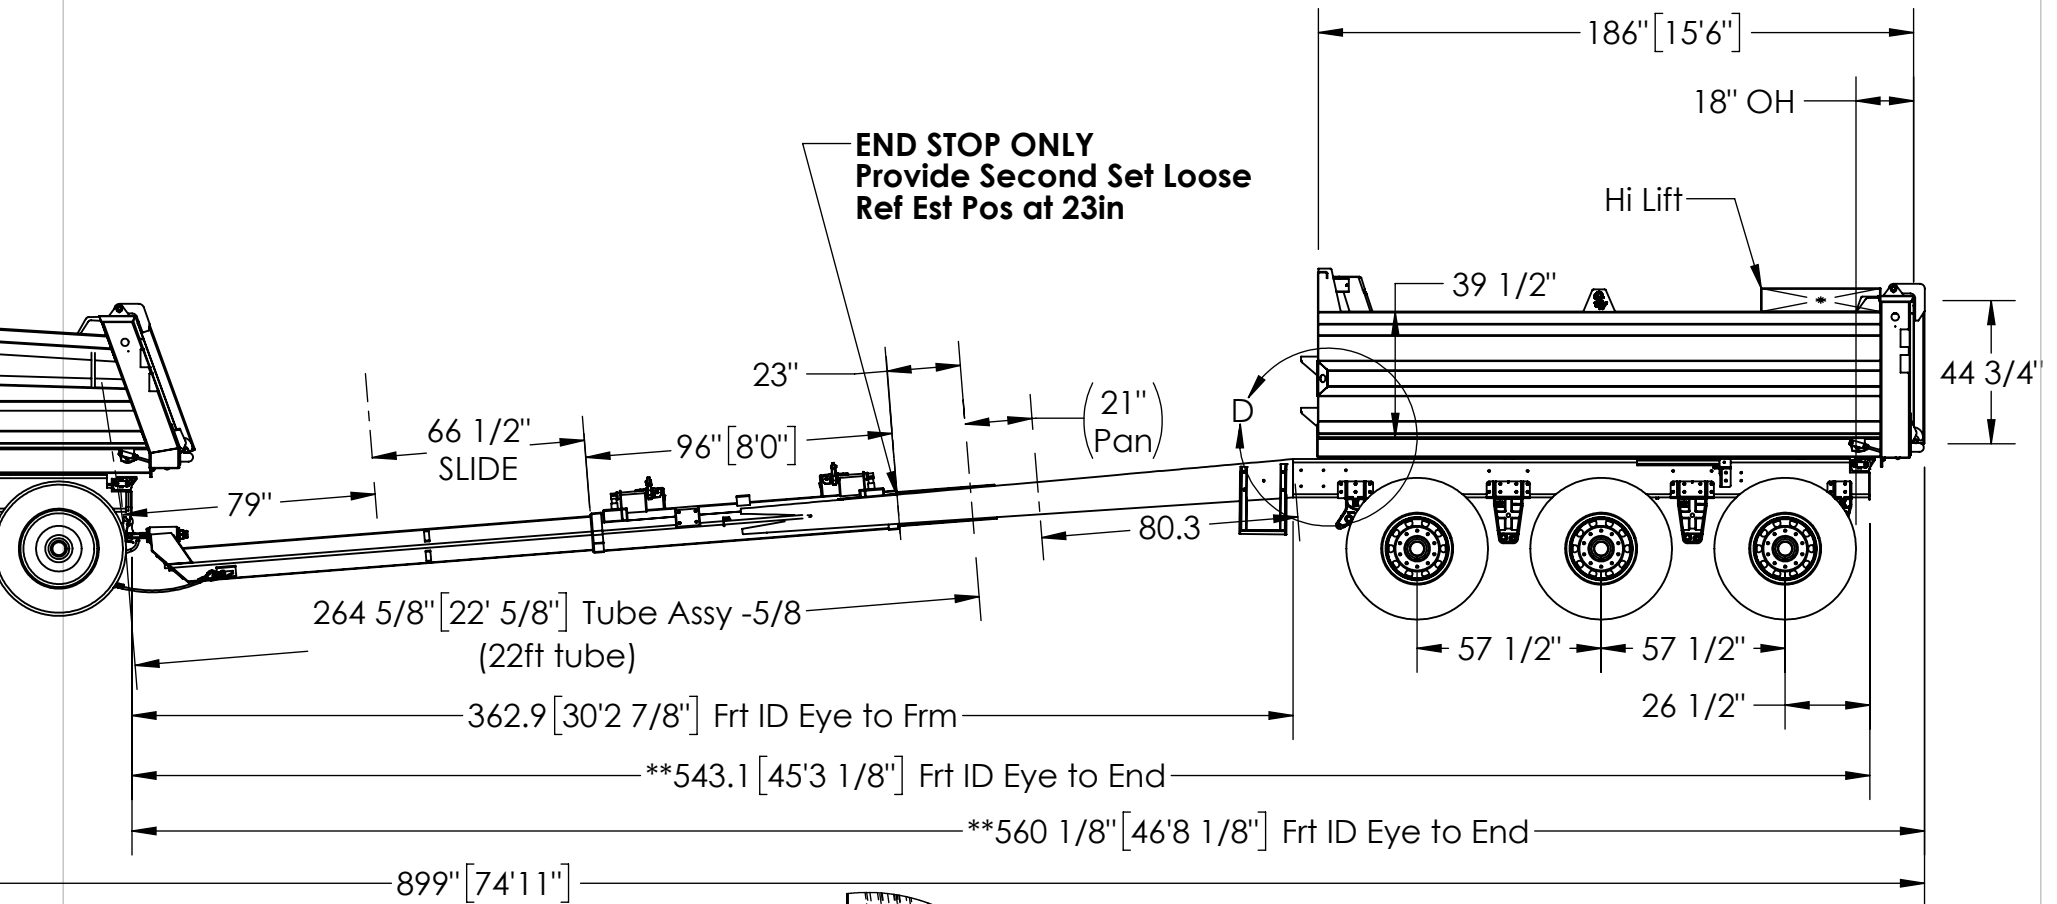

Cross Member Assy 60-12-03
Cyl Pos P2
Spacers 60-12-46 -03 (1/2in)

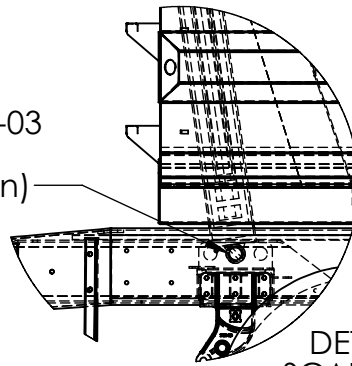

DETAIL D
SCALE 1 : 30

See SPEC for Body Details

Build Qty		501846 LAYOUT 12-19Rev0		
PROPRIETARY AND CONFIDENTIAL THE INFORMATION CONTAINED IN THIS DRAWING IS THE SOLE PROPERTY OF OSW Equipment & Repair, Inc. ANY REPRODUCTION IN PART OR AS A WHOLE WITHOUT THE WRITTEN PERMISSION OF OSW Equipment & Repair, Inc. IS PROHIBITED.		TITLE:		
		KWNW		
SIZE	DWG. NO.	REV		
A		0		
DO NOT SCALE DRAWING		SCALE: 1:60	WEIGHT:	SHEET 3 OF 3

ZONE	REV.	DESCRIPTION	DATE	APPROVED
		REVISIONS		009267

5

4

3

2

1